

EAST


[illegible]

LEGEND:

MW-01 MONITORING WELL
 <1.0 Well Identification
 Benzene Concentration in
 micrograms per liter (ug/l)

A & D MOBILE HOMES

CAREY LANE

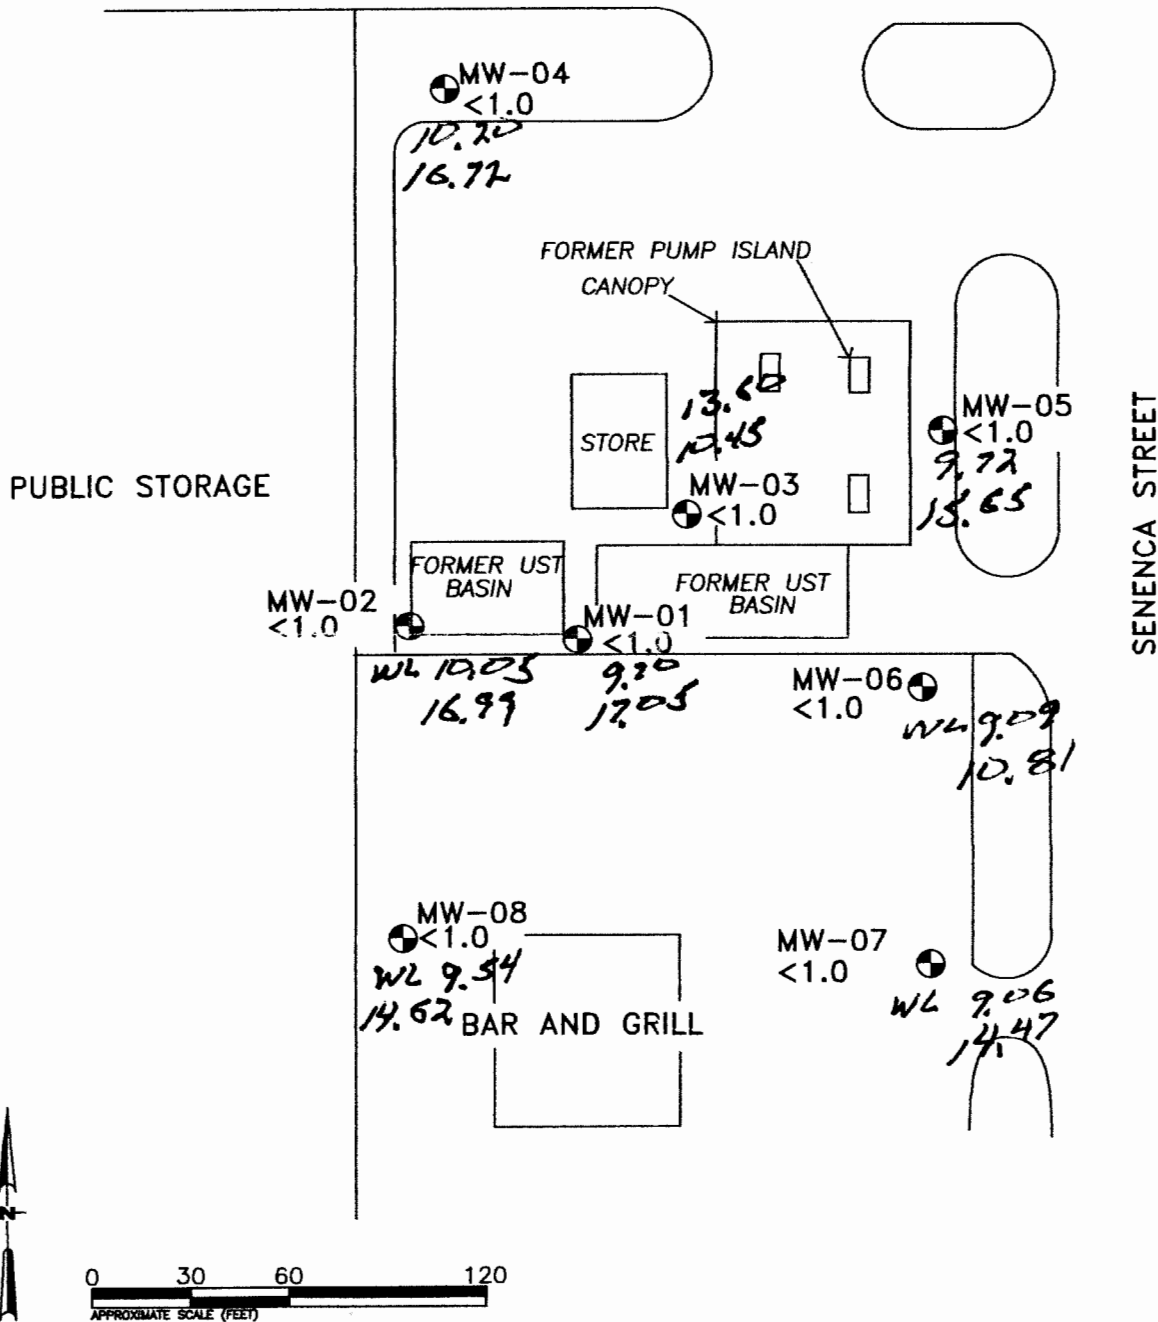

**BENZENE ISOCONTOUR MAP
 (JANUARY 2, 2008)**

TPI STATION NO. 2175
 3801 SOUTH SENECA
 WICHITA, KANSAS

FIGURE
 2

PROJECT NUMBER:
 17.75250.2175

CHECKED BY:
 JLA 01/16/08

DRAWING FILE: FIG4.DWG

DRAWN BY:
 JLA 04/06/07

VATC ASSOCIATES INC.