

WATER WELL RECORD MW-6

Form WWC-5

Division of Water Resources; App. No.

EAST

1 LOCATION OF WATER WELL:

County: Sedgewick

Fraction: NE 1/4 SE 1/4 SE 1/4

Section Number

Township Number

Range Number

Distance and direction from nearest town or city street address of well if located within city?

See map

Global Positioning Systems (decimal degrees, min. of 4 digits)

Latitude: N 37° 37' 32.1"

Longitude: W 97° 21' 10.8"

Elevation:

Datum:


Data Collection Method: Garmin Nv1

2 WATER WELL OWNER: TPI Station No 2175

RR#, St. Address, Box # : 3801 South Seneca

City, State, ZIP Code : Wichita KS

3 LOCATE WELL'S LOCATION WITH AN "X" IN SECTION BOX:

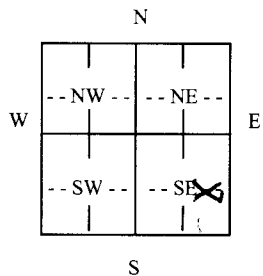

4 DEPTH OF COMPLETED WELL 15 ft.

Depth(s) Groundwater Encountered (1)..... ft. (2)..... ft. (3)..... ft.

WELL'S STATIC WATER LEVEL..... ft. below land surface measured on mo/day/yr.....

Pump test data: Well water was..... ft. after..... hours pumping..... gpm

Est. Yield..... gpm: Well water was..... ft. after..... hours pumping..... gpm

WELL WATER TO BE USED AS: 5 Public water supply 8 Air conditioning 11 Injection well

1 Domestic 3 Feedlot 6 Oil field water supply 9 Dewatering 12 Other (Specify below)

2 Irrigation 4 Industrial 7 Domestic (lawn & garden) 10 Monitoring well

Was a chemical/bacteriological sample submitted to Department? Yes..... No..... If yes, mo/day/yr

Sample was submitted..... N/A Water well disinfected? Yes..... No.....

5 TYPE OF CASING USED:

5 Wrought Iron

8 Concrete tile

CASING JOINTS: Glued..... Clamped.....

1 Steel

3 RMP (SR)

6 Asbestos-Cement

9 Other (specify below)

Welded.....

2 PVC

4 ABS

7 Fiberglass

Threaded.....

Blank casing diameter in. to ft., Diameter..... in. to ft., Diameter..... in. to ft.

Casing height above land surface..... in., Weight Sch 40 lbs./ft. Wall thickness or gauge No.

TYPE OF SCREEN OR PERFORATION MATERIAL:

1 Steel

3 Stainless Steel

5 Fiberglass

7 PVC

9 ABS

11 Other (Specify)

2 Brass

4 Galvanized Steel

6 Concrete tile

8 RM (SR)

10 Asbestos-Cement

12 None used (open hole)

SCREEN OR PERFORATION OPENINGS ARE:

1 Continuous slot

3 Mill slot

5 Gauzed wrapped

7 Torch cut

9 Drilled holes

11 None (open hole)

2 Louvered shutter

4 Key punched

6 Wire wrapped

8 Saw cut

10 Other (specify)

SCREEN-PERFORATED INTERVALS: From..... ft. to..... ft., From..... ft. to..... ft., From..... ft. to..... ft.

GRAVEL PACK INTERVALS: From..... ft. to..... ft., From..... ft. to..... ft., From..... ft. to..... ft.

6 GROUT MATERIAL:

1 Neat cement

2 Cement grout

3 Bentonite

4 Other

Grout Intervals: From..... ft. to..... ft., From..... ft. to..... ft., From..... ft. to..... ft.

What is the nearest source of possible contamination:

1 Septic tank

4 Lateral lines

7 Pit privy

10 Livestock pens

13 Insecticide storage

16 Other (specify

2 Sewer lines

5 Cess pool

8 Sewage lagoon

11 Fuel storage

14 Abandoned water well

below)

3 Watertight sewer lines

6 Seepage pit

9 Feedyard

12 Fertilizer storage

15 Oil well/gas well

Direction from well? How many feet?

FROM	TO	LITHOLOGIC LOG	FROM	TO	PLUGGING INTERVALS
			0	6"	Concrete
			6"	2'	Top soil
			2'	15'	Bentonite

7 CONTRACTOR'S OR LANDOWNER'S CERTIFICATION: This water well was (1) constructed, (2) reconstructed, or (3) plugged

under my jurisdiction and was completed on (mo/day/yr) 8-14-08 and this record is true to the best of my knowledge and belief.

Kansas Water Well Contractor's License No. 759 This Water Well Record was completed on (mo/day/yr) 8-23-08

under the business name of RAZEK Environmental LLC by (signature) [Signature]

INSTRUCTIONS: Use typewriter or ball point pen. PLEASE PRESS FIRMLY and PRINT clearly. Please fill in blanks, underline or circle the correct answers. Send top three copies to Kansas Department of Health and Environment, Bureau of Water, Geology Section, 1000 SW Jackson St., Suite 420, Topeka, Kansas 66612-1367. Telephone 785-296-5522. Send one to WATER WELL OWNER and retain one for your records. Fee of \$5.00 for each constructed well. Visit us at <http://www.kdheks.gov/waterwell/index.html>.

KSA 82a-1212

LEGEND:


MW-01 MONITORING WELL
 <1.0 Well Identification
 Benzene Concentration in
 micrograms per liter (ug/l)

A & D MOBILE HOMES

CAREY LANE

PUBLIC STORAGE

SENECA STREET

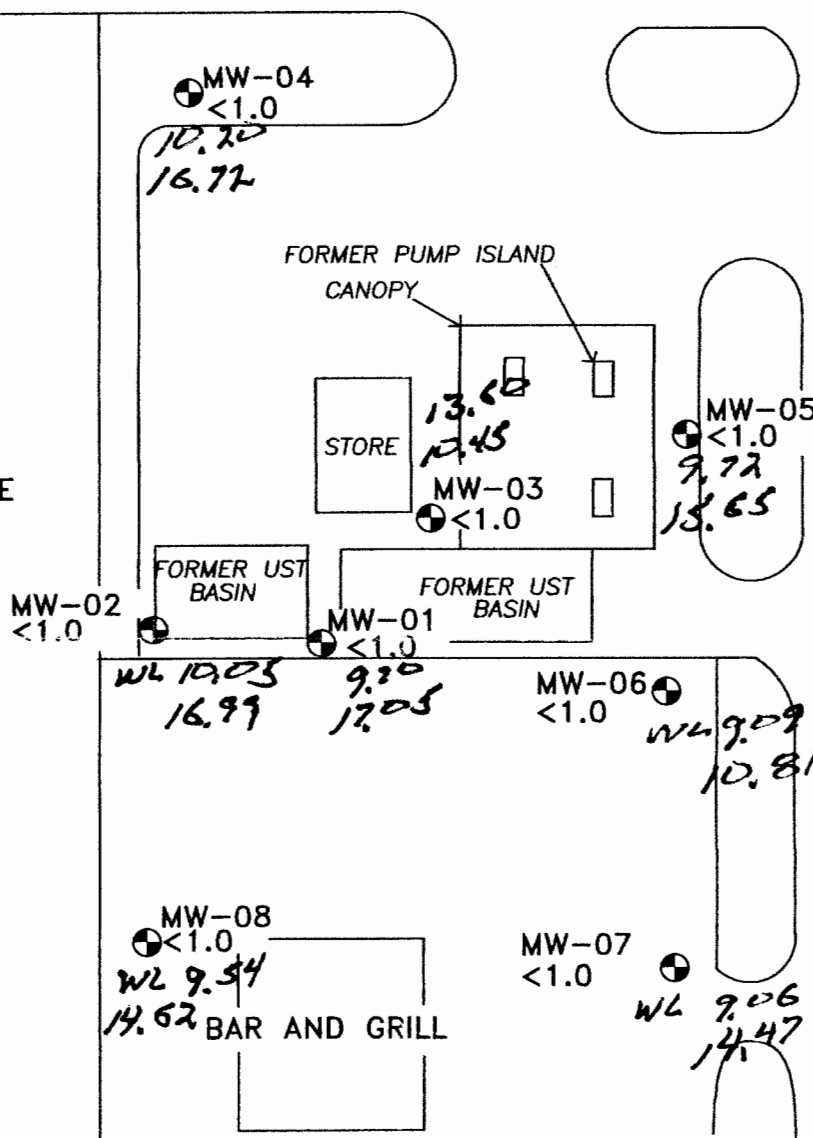

0 30 60 120
 APPROXIMATE SCALE (FEET)

**BENZENE ISOCONTOUR MAP
 (JANUARY 2, 2008)**

TPI STATION NO. 2175
 3801 SOUTH SENECA
 WICHITA, KANSAS

FIGURE
 2

PROJECT NUMBER:
 17.75250.2175

CHECKED BY:

JLA 01/16/08

DRAWING FILE: FIG4.DWG

DRAWN BY:
 JLA 04/06/07

VATC ASSOCIATES INC.