

CORRECTION(S) TO WATER WELL RECORD (WWC-5)
(to rectify lacking or incorrect information)

County: Sedgwick

Location listed as:

Location changed to:

Section-Township-Range: None Given

21-285-1E

Fraction ($\frac{1}{4}$ $\frac{1}{4}$ $\frac{1}{4}$): _____

W2 NW SW SW

Other changes: Initial statements: Owner's name illegible.

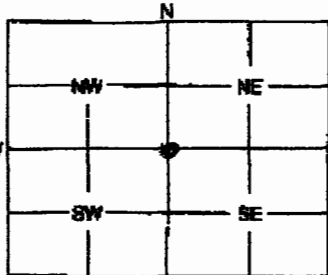
Changed to: Deanna Turpin (per Sedgwick County
Appraiser's online parcel search).

Comments: _____

verification method: Well owner's address, city street map, and
mapping tool on KGS website.

initials: DRL date: 5/20/2009

submitted by: Kansas Geological Survey, Data Resources Library, 1930 Constant Ave., Lawrence, KS 66047-3726
to: Kansas Dept of Health & Environment, Bureau of Water, 1000 SW Jackson, Suite 420, Topeka, KS 66612-1367.

1 LOCATION OF WATER WELL:	Fraction	Section Number	Township Number	Range Number																											
County: <u>Seelye</u>	<u>1/4</u> <u>1/4</u> <u>1/4</u>			EW																											
Distance and direction from nearest town or city street address of well if located within city? <u>Wichita</u>																															
2 WATER WELL OWNER: <u>Deanna Turpin</u>																															
RR #, St. Address, Box #: <u>304 E. Maywood</u>		Board of Agriculture, Division of Water Resources																													
City, State, ZIP Code: <u>Wichita, KS 67216</u>		Application Number:																													
3 MARK WELL'S LOCATION WITH AN "X" IN SECTION BOX: 		4 DEPTH OF WELL <u>5</u> ft.																													
		WELL'S STATIC WATER LEVEL <u> </u> ft.																													
		WELL WAS USED AS:																													
		1 Domestic 5 Public Water Supply 9 Dewatering 2 Irrigation 6 Oil Field Water Supply 10 Monitoring Well 3 Feedlot 7 Domestic (Lawn & Garden) 11 Injection Well 4 Industrial 8 Air Conditioning 12 Other <u> </u>																													
		Was a chemical / bacteriological sample submitted to Department? Yes <u> </u> No <u> </u>																													
		If yes, mo/day/yr sample was submitted <u> </u>																													
		Water Well Disinfected: Yes <u>✓</u> No <u> </u>																													
5 TYPE OF BLANK CASING USED:																															
1 Steel 3 RMP (SR) 5 Wrought 7 Fiberglass 9 Other (Specify below) 2 PVC 4 ABS 6 Asbestos-Cement 8 Concrete Tile																															
Blank casing diameter <u> </u> in. Was casing pulled? Yes <u> </u> No <u>✓</u> If yes, how much <u> </u>																															
Casing height above or below land surface <u>36</u> in.																															
6 GROUT PLUG MATERIAL: <u>1 Neat cement</u> 2 Cement grout 3 Bentonite 4 Other <u> </u>																															
Grout Plug Intervals: From <u>5</u> ft. to <u>30</u> ft., From <u> </u> ft. to <u> </u> ft., From <u> </u> ft. to <u> </u> ft.																															
What is the nearest source of possible contamination:																															
1 Septic tank 6 Seepage pit 11 Fuel storage 16 Other (specify below) 2 Sewer lines 7 Pit privy 12 Fertilizer storage 3 Water-tight sewer lines 8 Sewage lagoon 13 Insecticide storage 4 Lateral lines 9 Feedyard 14 Abandoned water well 5 Cess pool 10 Livestock pens 15 Oil well/Gas well																															
Direction from well? <u>7</u> How many feet? <u>10</u>																															
<table border="1" style="width:100%; border-collapse: collapse;"> <thead> <tr> <th style="width:15%;">FROM</th> <th style="width:15%;">TO</th> <th style="width:70%;">PLUGGING MATERIALS</th> </tr> </thead> <tbody> <tr> <td><u>0</u></td> <td><u>5</u></td> <td><u>Topsoil</u></td> </tr> <tr> <td><u>3</u></td> <td><u>30</u></td> <td><u>Cement</u></td> </tr> <tr><td> </td><td> </td><td> </td></tr> <tr><td> </td><td> </td><td> </td></tr> <tr><td> </td><td> </td><td> </td></tr> <tr><td> </td><td> </td><td> </td></tr> <tr><td> </td><td> </td><td> </td></tr> <tr><td> </td><td> </td><td> </td></tr>
7 CONTRACTOR'S OR LANDOWNER'S CERTIFICATION: This water well was plugged under my jurisdiction and was completed on (mo/day/year) <u>1-19-09</u> and this record is true to the best of my knowledge and belief. Kansas Water Well Contractor's License No. <u>1-19-09</u> under the business name of <u> </u> This Water Well Record was completed on (mo/day/year) <u> </u> by (signature) <u> </u>																															
INSTRUCTIONS: Use typewriter or ball point pen. Please press firmly and print clearly. Please fill in blanks, underline or circle the correct answers. Send top three copies to Kansas Department of Health and Environment, Bureau of Water, Geology Section, 1000 SW Jackson St., Ste. 420, Topeka, Kansas 66612-1367. Telephone: 785/296-5522. Send one to Water Well Owner and retain one for your records.																															