CORRECTION(S) TO WATER WELL RECORD (WWC-5)
(to rectify lacking or incorrect information)

County: Sedgwick

Location listed as:	**Location changed to:**
Section-Township-Range: 27 - 1 E	16 - 28 S - 1 E
Fraction (¼ ¼ ¼): None Given	W2 SE

Other changes: Initial statements:

Changed to:

Comments:

verification method: Wellsite address, city street map, and mapping tool on KGS website.

initials: DRL date: 6/9/2009

submitted by: Kansas Geological Survey, Data Resources Library, 1930 Constant Ave., Lawrence, KS 66047-3726
to: Kansas Dept of Health & Environment, Bureau of Water, 1000 SW Jackson, Suite 420, Topeka, KS 66612-1367.

WATER WELL PLUGGING RECORD Form WWC-5P KSA 82a-1212 ID NO.

1 LOCATION OF WATER WELL: County: SG	Fraction ¼ ¼ ¼	Section Number	Township Number 27	Range Number 1 (E)/W

Distance and direction from nearest town or city street address of well if located within city?
1100 E 45th St. S. Wichita Ks 67216

2 WATER WELL OWNER: Neil Doctorman

RR#, St. Address, Box #: Same as above

City, State ZIP Code:

Global Positioning Systems (decimal degrees, min. of 4 digits
Latitude: _____
Longitude: _____
Elevation: _____
Datum: _____
Data Collection Method:

3 MARK WELL'S LOCATION WITH AN "X" IN SECTION BOX:

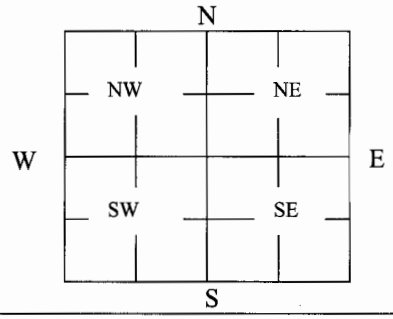

4 DEPTH OF WELL 28 ft.

WELL'S STATIC WATER LEVEL 18 ft

WELL WAS USED AS:

1 Domestic 5 Public Water Supply 9 Dewatering
(2) Irrigation 6 Oil Field Water Supply 10 Monitoring
3 Feedlot 7 Domestic (Lawn & Garden) 11 Injection Well
4 Industrial 8 Air Conditioning 12 Other _____

Was a chemical/bacteriological sample submitted to Department? Yes _____ No ✓

5 TYPE OF BLANK CASING USED:

(1) Steel 3 RMP (SR) 5 Wrought 7 Fiberglass 9 Other (Specify below)
2 PVC 4 ABS 6 Asbestos-Cement 8 Concrete Tile _____

Blank casing diameter 6 in. Was casing pulled? Yes _____ No ✓ If yes, how much _____
Casing height above or below land surface _____ in.

6 GROUT PLUG MATERIAL: 1 Neat cement (2) Cement grout 3 Bentonite 4 Other _____

Grout Plug Intervals: From _____ ft. to _____ ft., From _____ ft. to _____ ft., From _____ to _____ ft.

What is the nearest source of possible contamination:

1 Septic tank 6 Seepage pit 11 Fuel Storage 16 Other (specify below)
(2) Sewer lines 7 Pit privy 12 Fertilizer storage _____
3 Watertight sewer lines 8 Sewage lagoon 13 Insecticide storage
4 Lateral lines 9 Feedyard 14 Abandoned water well Direction from well? above it
5 Cess pool 10 Livestock pens 15 Oil well/Gas well How many feet? 1

FROM	TO	PLUGGING MATERIALS	FROM	TO	PLUGGING MATERIALS
28	26	Sand			
26	0	Concrete			

7 CONTRACTOR'S OR LANDOWNER'S CERTIFICATION: This water well was plugged under my jurisdiction and was completed on (mo/day/year) 02/17/2009 and this record is true to the best of my knowledge and belief. Kansas Water Well Contractor's License No. _____. This Water Well Record was completed on (mo/day/year) 02/18/2009 under the business name of _____ by (signature) Neil Doctorman

INSTRUCTIONS: Use typewriter or ballpoint pen. Please press firmly and print clearly. Please fill in blanks, underline or circle the correct answers. Send top three copies to Kansas Department of Health and Environment, Bureau of Water, Geology Section, 1000 SW Jackson St., Ste. 420, Topeka, Kansas 66612-1367. Telephone: 785/296-5522. Send one to Water Well Owner and retain one for your records. Visit us at http://www.kdheks.gov/geo/waterwells.