

WATER WELL PLUGGING RECORD Form WWC-5P KSA 82a-1212 ID NO.


1 **LOCATION OF WATER WELL:** County: SeOgwick Fraction SW 1/4 SW 1/4 SE 1/4 Section Number 13 Township Number 28 Range Number 12 E

Distance and direction from nearest town or city street address of well if located within city?

South end of Runway - McConnell AFB, Building 1560 Wichita, KS

2 **WATER WELL OWNER:** Kansas Air National Guard Global Positioning Systems (decimal degrees, min. of 4 digits)
 RR#, St. Address, Box #: C/O P.M.C. Latitude: _____
 City, State ZIP Code: Wichita, KS 67201 Longitude: _____
 Elevation: _____
 Datum: _____
 Data Collection Method: _____

3 **MARK WELL'S LOCATION WITH AN "X" IN SECTION BOX:**

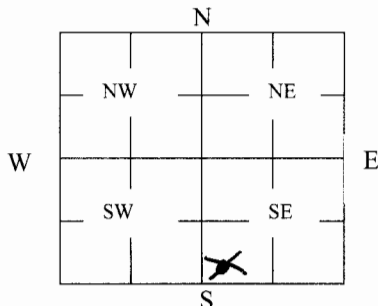

4 **DEPTH OF WELL** 250 ft. At 5 holes

WELL'S STATIC WATER LEVEL 9 ft

WELL WAS USED AS:

- | | | |
|--------------|----------------------------|-----------------------------|
| 1 Domestic | 5 Public Water Supply | 9 Dewatering |
| 2 Irrigation | 6 Oil Field Water Supply | 10 Monitoring |
| 3 Feedlot | 7 Domestic (Lawn & Garden) | 11 Injection Well |
| 4 Industrial | 8 Air Conditioning | 12 <u>Other Geo-thermal</u> |

Was a chemical/bacteriological sample submitted to Department? Yes _____ No X

5 **TYPE OF BLANK CASING USED:** 1" SDR 9 Polyethylene loops
 1 Steel 3 RMP (SR) 5 Wrought 7 Fiberglass 9 Other (Specify below)
 2 PVC 4 ABS 6 Asbestos-Cement 8 Concrete Tile NONE

Blank casing diameter 1 1/2 in. Was casing pulled? Yes _____ No X If yes, how much _____
 Casing height above or below land surface 80 in.

6 **GROUT PLUG MATERIAL:** 1 Neat cement 2 Cement grout 3 Bentonite 4 Other _____

Grout Plug Intervals: From 5 ft. to 250 ft., From _____ ft. to _____ ft., From _____ to _____ ft.

What is the nearest source of possible contamination:

- | | | | |
|--------------------------|-------------------|-------------------------|--|
| 1 Septic tank | 6 Seepage pit | 11 Fuel Storage | 16 Other (specify below) <u>NONE within 1/4 mile</u> |
| 2 Sewer lines | 7 Pit privy | 12 Fertilizer storage | |
| 3 Watertight sewer lines | 8 Sewage lagoon | 13 Insecticide storage | |
| 4 Lateral lines | 9 Feedyard | 14 Abandoned water well | Direction from well? _____ |
| 5 Cess pool | 10 Livestock pens | 15 Oil well/Gas well | How many feet? _____ |

FROM	TO	PLUGGING MATERIALS	FROM	TO	PLUGGING MATERIALS
<u>0</u>	<u>5</u>	<u>Top Soil</u>			
<u>5</u>	<u>250</u>	<u>Bentonite / sand grout</u>			

7 **CONTRACTOR'S OR LANDOWNER'S CERTIFICATION:** This water well was plugged under my jurisdiction and was completed on (mo/day/year) 10-16-09 and this record is true to the best of my knowledge and belief. Kansas Water Well Contractor's License No. 138. This Water Well Record was completed on (mo/day/year) 10-23-09 under the business name of Peterson Irrigation by (signature) Mike Peterson

INSTRUCTIONS: Use typewriter or ballpoint pen. Please press firmly and print clearly. Please fill in blanks, underline or circle the correct answers. Send top three copies to Kansas Department of Health and Environment, Bureau of Water, Geology Section, 1000 SW Jackson St., Ste. 420, Topeka, Kansas 66612-1367. Telephone: 785/296-5522. Send one to Water Well Owner and retain one for your records. Visit us at <http://www.kdheks.gov/geo/waterwells>.