

## WATER WELL PLUGGING RECORD Form WWC-5P KSA 82a-1212 ID NO.

|                           |                       |                |                 |              |
|---------------------------|-----------------------|----------------|-----------------|--------------|
| 1 LOCATION OF WATER WELL: | Fraction              | Section Number | Township Number | Range Number |
| County: <b>Sedgwick</b>   | <b>NW ¼ SW ¼ NW ¼</b> | <b>12</b>      | <b>28 S</b>     | <b>01 E</b>  |

Distance and direction from nearest town or city street address of well if located within city?  
**3850 S. Oliver, Wichita, Kansas (Southeast of former Boeing Activity Center on 500 ramp)**

## 2 WATER WELL OWNER: Boeing Company

RR#, St. Address, Box #: 2727 E MacArthur

City, State, ZIP Code: Wichita, KS 67217

Global Positioning System (decimal degrees, min. of 4 digits)

Latitude: \_\_\_\_\_

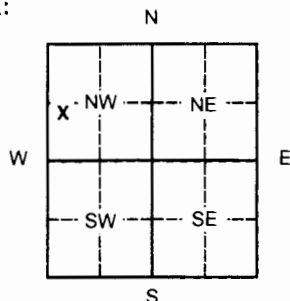
Longitude: \_\_\_\_\_

Elevation: \_\_\_\_\_

Datum: \_\_\_\_\_

Data Collection Method: \_\_\_\_\_

## 3 MARK WELL'S LOCATION WITH AN "X" IN SECTION BOX:

4 DEPTH OF WELL 36.7 ft.WELL'S STATIC WATER LEVEL 10.67 ft

WELL WAS USED AS:

- |              |                            |                      |
|--------------|----------------------------|----------------------|
| 1 Domestic   | 5 Public Water Supply      | 9 Dewatering         |
| 2 Irrigation | 6 Oil Field Water Supply   | 10 <b>Monitoring</b> |
| 3 Feedlot    | 7 Domestic (Lawn & Garden) | 11 Injection Well    |
| 4 Industrial | 8 Air Conditioning         | 12 Other _____       |

Was a chemical/bacteriological sample submitted to Department? Yes \_\_\_ No x

## 5 TYPE OF BLANK CASING USED:

- |              |            |                   |                 |                         |
|--------------|------------|-------------------|-----------------|-------------------------|
| 1 Steel      | 3 RMP (SR) | 5 Wrought         | 7 Fiberglass    | 9 Other (Specify below) |
| 2 <b>PVC</b> | 4 ABS      | 6 Asbestos-Cement | 8 Concrete Tile |                         |

Blank casing diameter 2 in. Was casing pulled? Yes \_\_\_ No X If yes, how much \_\_\_\_\_  
 Casing height above or below land surface \_\_\_\_\_ in.

6 GROUT PLUG MATERIAL: 1 Neat cement 2 Cement grout 3 **Bentonite** 4 Other SoilGrout Plug Intervals: From 0 ft. to 36.7 ft., From \_\_\_\_\_ ft. to \_\_\_\_\_ ft., From \_\_\_\_\_ to \_\_\_\_\_ ft.

What is the nearest source of possible contamination:

- |                          |                   |                         |                          |
|--------------------------|-------------------|-------------------------|--------------------------|
| 1 Septic tank            | 6 Seepage pit     | 11 Fuel Storage         | 16 Other (specify below) |
| 2 Sewer lines            | 7 Pit privy       | 12 Fertilizer storage   |                          |
| 3 Watertight sewer lines | 8 Sewage lagoon   | 13 Insecticide storage  |                          |
| 4 Lateral lines          | 9 Feedyard        | 14 Abandoned water well | Direction from well?     |
| 5 Cess pool              | 10 Livestock pens | 15 Oil well/Gas well    | How many feet?           |

| FROM | TO    | PLUGGING MATERIALS | FROM | TO | PLUGGING MATERIALS |
|------|-------|--------------------|------|----|--------------------|
| 0    | 36.70 | Bentonite          |      |    |                    |
|      |       |                    |      |    |                    |
|      |       |                    |      |    |                    |
7 CONTRACTOR'S OR LANDOWNER'S CERTIFICATION: This water well was plugged under my jurisdiction and was completed on (mo/day/year) 12-9-2010 and this record is true to the best of my knowledge and belief. Kansas Water Well Contractor's License No. 531. This Water Well Record was completed on (mo/day/year) 2/21/2011 under the business name of Geotechnical Services, Inc. by (signature) [Signature]

INSTRUCTIONS: Please fill in blanks or circle the correct answers. Send top three copies to Kansas Department of Health and Environment, Bureau of Water, Geology Section, 1000 SW Jackson St., Ste. 420, Topeka, Kansas 66612-1367. Telephone: 785/296-5522. Send one to Water Well Owner and retain one for your records. Visit us at <http://www.kdheks.gov/waterwell>.