

WATER WELL PLUGGING RECORD Form WWC-5P

KSA 82a-1212

ID NO.

MW-2R

1 LOCATION OF WATER WELL: Fraction SW 1/4 SW 1/4 SW 1/4 Section Number 3 Township Number 28 S Range Number R 1 E
Sedgwick County

Distance and direction from nearest town or city street address of well if located within city?

Well was located at 2736 S. Hydraulic, Wichita, KS

2 WATER WELL OWNER:

Quik Trip #328C
RR#, St. Address, Box #:
2736 S. Hydraulic
City, State ZIP Code:
Wichita, KS 67216

Global Positioning Systems (decimal degrees, min. of 4 digits)

Latitude: _____


Longitude: _____

Elevation: _____

Datum: _____

Data Collection Method: _____

3 MARK WELL'S LOCATION WITH AN "X" IN SECTION BOX:

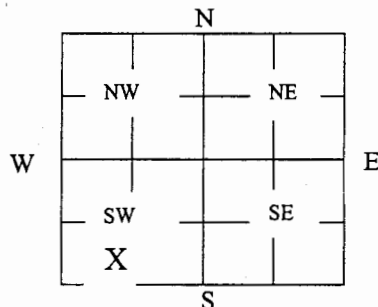

4 DEPTH OF WELL 19.30 ft.

WELL'S STATIC WATER LEVEL 15.56 ft

WELL WAS USED AS: ☒ X

- 1 Domestic
- 2 Irrigation
- 3 Feedlot
- 4 Industrial

- 5 Public Water Supply
- 6 Oil Field Water Supply
- 7 Domestic (Lawn & Garden)
- 8 Air Conditioning

- 9 Dewatering
- 10 Monitoring
- 11 Injection Well
- 12 Other _____

Was a chemical/bacteriological sample submitted to Department? Yes _____ No x _____

5 TYPE OF BLANK CASING USED:

- 1 Steel
- 3 RMP (SR)
- 5 Wrought
- 7 Fiberglass
- 9 Other (Specify below) _____
- 2 PVC
- 4 ABS
- 6 Asbestos-Cement
- 8 Concrete Tile

Blank casing diameter 2 in. Was casing pulled? Yes x No _____ If yes, how much 3'

Casing height above or below land surface _____ in.

6 GROUT PLUG MATERIAL: 1 Neat cement 2 Cement grout 3 Bentonite 4 Other Soil

Grout Plug Intervals: From 4 0 ft. to 3 ft., From 3 3 ft. to 19.30 ft., From _____ to _____ ft.

What is the nearest source of possible contamination:

- 1 Septic tank
- 2 Sewer lines
- 3 Watertight sewer lines
- 4 Lateral lines
- 5 Cess pool
- 6 Seepage pit
- 7 Pit privy
- 8 Sewage lagoon
- 9 Feedyard
- 10 Livestock pens
- 11 Fuel Storage
- 12 Fertilizer storage
- 13 Insecticide storage
- 14 Abandoned water well
- 15 Oil well/Gas well
- 16 Other (specify below) _____
Contaminated Site _____
Direction from well? _____
How many feet? _____

FROM	TO	PLUGGING MATERIALS	FROM	TO	PLUGGING MATERIALS
0'	3'	Soil			
3'	19.30'	Bentonite Chips			

7 CONTRACTOR'S OR LANDOWNER'S CERTIFICATION: This water well was plugged under my jurisdiction and was completed on (mo/day/year) 02/21/11 and this record is true to the best of my knowledge and belief. Kansas Water Well Contractor's License No. 585. This Water Well Record was completed on (mo/day/year) 02/25/11 under the business name of Associated Environmental, Inc. by (signature) [Signature]

INSTRUCTIONS: Use typewriter or ballpoint pen. Please press firmly and print clearly. Please fill in blanks, underline or circle the correct answers. Send top three copies to Kansas Department of Health and Environment, Bureau of Water, Geology Section, 1000 SW Jackson St., Ste. 420, Topeka, Kansas 66612-1367. Telephone: 785/296-5522. Send one to Water Well Owner and retain one for your records. Visit us at <http://www.kdheks.gov/waterwell/index.html>.