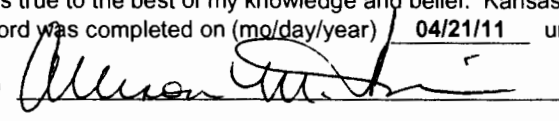


Cost of Exchange: 11.11%

1 LOCATION OF WATER WELL: County: Sedgwick		Fraction NE ¼ SE ¼ SW ¼	Section Number 5	Township Number 28S	Range Number 1	
Distance and direction from nearest town or city street address of well if located within city? 3001 S. Exchange Pl. - Wichita	
2 WATER WELL OWNER: USD 259 RR#, St. Address, Box #: 3850 N. Hydraulic City, State, ZIP Code: Wichita, KS 67219			Global Positioning System (decimal degrees, min. of 4 digits) Latitude: _____ Longitude: _____ Elevation: _____ Datum: _____ Data Collection Method: _____	
3 MARK WELL'S LOCATION WITH AN "X" IN SECTION BOX: N <table border="1" style="margin: auto;"><tr><td></td><td></td><td></td></tr><tr><td>NW</td><td></td><td>NE</td></tr><tr><td>W</td><td></td><td>E</td></tr><tr><td>SW</td><td>X</td><td>SE</td></tr><tr><td></td><td></td><td></td></tr><tr><td colspan="3" style="text-align: center;">S</td></tr></table>					NW		NE	W		E	SW	X	SE				S			4 DEPTH OF WELL <u>23.77</u> ft. WELL'S STATIC WATER LEVEL <u>19.76</u> ft. WELL WAS USED AS: <table style="width:100%;"><tr><td>1 Domestic</td><td>5 Public Water Supply</td><td>9 Dewatering</td></tr><tr><td>2 Irrigation</td><td>6 Oil Field Water Supply</td><td>10 Monitoring</td></tr><tr><td>3 Feedlot</td><td>7 Domestic (Lawn & Garden)</td><td>11 Injection Well</td></tr><tr><td>4 Industrial</td><td>8 Air Conditioning</td><td>12 <u>Other</u> Sand Point</td></tr></table> Was a chemical/bacteriological sample submitted to Department? Yes ___ No <u>X</u>				1 Domestic	5 Public Water Supply	9 Dewatering	2 Irrigation	6 Oil Field Water Supply	10 Monitoring	3 Feedlot	7 Domestic (Lawn & Garden)	11 Injection Well	4 Industrial	8 Air Conditioning	12 <u>Other</u> Sand Point												
NW		NE	
W		E	
SW	X	SE	
S	
1 Domestic	5 Public Water Supply	9 Dewatering	
2 Irrigation	6 Oil Field Water Supply	10 Monitoring	
3 Feedlot	7 Domestic (Lawn & Garden)	11 Injection Well	
4 Industrial	8 Air Conditioning	12 <u>Other</u> Sand Point	
5 TYPE OF BLANK CASING USED: <table style="width:100%;"><tr><td>1 <u>Steel</u></td><td>3 RMP (SR)</td><td>5 Wrought</td><td>7 Fiberglass</td><td>9 Other (Specify below)</td></tr><tr><td>2 PVC</td><td>4 ABS</td><td>6 Asbestos-Cement</td><td>8 Concrete Tile</td><td></td></tr></table> Blank casing diameter <u>1.5</u> in. Was casing pulled? Yes <u>X</u> No ___ If yes, how much <u>5</u> ft. Casing height above or <u>below</u> land surface <u>60</u> in.						1 <u>Steel</u>	3 RMP (SR)	5 Wrought	7 Fiberglass	9 Other (Specify below)	2 PVC	4 ABS	6 Asbestos-Cement	8 Concrete Tile																																	
1 <u>Steel</u>	3 RMP (SR)	5 Wrought	7 Fiberglass	9 Other (Specify below)	
2 PVC	4 ABS	6 Asbestos-Cement	8 Concrete Tile	
6 GROUT PLUG MATERIAL: 1 Neat cement 2 Cement grout 3 <u>Bentonite</u> 4 Other _____ Grout Plug Intervals: From <u>0.5</u> ft. to <u>23.77</u> ft., From _____ ft. to _____ ft., From _____ to _____ ft. What is the nearest source of possible contamination: <table style="width:100%;"><tr><td>1 Septic tank</td><td>6 Seepage pit</td><td>11 Fuel Storage</td><td>16 Other (specify below)</td></tr><tr><td>2 Sewer lines</td><td>7 Pit privy</td><td>12 Fertilizer storage</td><td></td></tr><tr><td>3 Watertight sewer lines</td><td>8 Sewage lagoon</td><td>13 Insecticide storage</td><td></td></tr><tr><td>4 Lateral lines</td><td>9 Feedyard</td><td>14 Abandoned water well</td><td>Direction from well?</td></tr><tr><td>5 Cess pool</td><td>10 Livestock pens</td><td>15 Oil well/Gas well</td><td>How many feet?</td></tr></table>						1 Septic tank	6 Seepage pit	11 Fuel Storage	16 Other (specify below)	2 Sewer lines	7 Pit privy	12 Fertilizer storage		3 Watertight sewer lines	8 Sewage lagoon	13 Insecticide storage		4 Lateral lines	9 Feedyard	14 Abandoned water well	Direction from well?	5 Cess pool	10 Livestock pens	15 Oil well/Gas well	How many feet?																						
1 Septic tank	6 Seepage pit	11 Fuel Storage	16 Other (specify below)	
2 Sewer lines	7 Pit privy	12 Fertilizer storage	
3 Watertight sewer lines	8 Sewage lagoon	13 Insecticide storage	
4 Lateral lines	9 Feedyard	14 Abandoned water well	Direction from well?	
5 Cess pool	10 Livestock pens	15 Oil well/Gas well	How many feet?	
<table border="1" style="width:100%; border-collapse: collapse;"><thead><tr><th>FROM</th><th>TO</th><th>PLUGGING MATERIALS</th><th>FROM</th><th>TO</th><th>PLUGGING MATERIALS</th></tr></thead><tbody><tr><td>0</td><td>0.5</td><td>Native Soil</td><td></td><td></td><td></td></tr><tr><td>0.5</td><td>23.77</td><td>Bentonite Chips</td><td></td><td></td><td></td></tr><tr><td> </td><td> </td><td> </td><td> </td><td> </td><td> </td></tr><tr><td> </td><td> </td><td> </td><td> </td><td> </td><td> </td></tr><tr><td> </td><td> </td><td> </td><td> </td><td> </td><td> </td></tr><tr><td> </td><td> </td><td> </td><td> </td><td> </td><td> </td></tr></tbody></table>						FROM	TO	PLUGGING MATERIALS	FROM	TO	PLUGGING MATERIALS	0	0.5	Native Soil				0.5	23.77	Bentonite Chips																											
FROM	TO	PLUGGING MATERIALS	FROM	TO	PLUGGING MATERIALS	
0	0.5	Native Soil	
0.5	23.77	Bentonite Chips	
7 CONTRACTOR'S OR LANDOWNER'S CERTIFICATION: This water well was plugged under my jurisdiction and was completed on (mo/day/year) <u>04/14/11</u> and this record is true to the best of my knowledge and belief. Kansas Water Well Contractor's License No. <u>531</u> . This Water Well Record was completed on (mo/day/year) <u>04/21/11</u> under the business name of <u>Geotechnical Services, Inc.</u> by (signature) 	
INSTRUCTIONS: Please fill in blanks or circle the correct answers. Send top three copies to Kansas Department of Health and Environment, Bureau of Water, Geology Section, 1000 SW Jackson St., Ste. 420, Topeka, Kansas 66612-1367. Telephone: 785/296-5522. Send one to Water Well Owner and retain one for your records. Visit us at http://www.kdheks.gov/waterwell .	