

1 LOCATION OF WATER WELL:	Fraction	Section Number	Township Number	Range Number
County: Sedgwick	NW ¼ NE ¼ NE ¼	7	T 28 S	R 1 E/W

Distance and direction from nearest town or city street address of well if located within city?

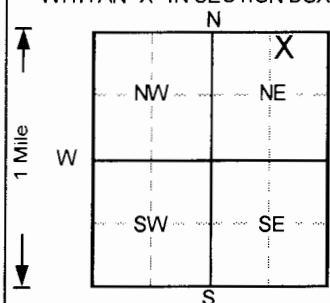
1501 W. 31st St., Wichita2 WATER WELL OWNER: **Richardson & Associates, LLC**RR#, St. Address, Box # : **3021 N. Ridge Port Ct.**

Board of Agriculture, Division of Water Resources

City, State, ZIP Code : **Wichita, Kansas 67205**

Application Number:

3 LOCATE WELL'S LOCATION WITH AN "X" IN SECTION BOX:

4 DEPTH OF COMPLETED WELL: **30** ft. ELEVATION:

Depth(s) Groundwater Encountered 1. ft. 2. ft. 3. ft.

WELL'S STATIC WATER LEVEL ft. below land surface measured on mo/day/yr

Pump test data: Well water was **NA** ft. after hours pumping gpmEst. Yield **NA** gpm: Well water was ft. after hours pumping gpmBore Hole Diameter **8** in. to **30** ft. and in. to ft.

WELL WATER TO BE USED AS: 5 Public water supply 8 Air conditioning 11 Injection well

1 Domestic 3 Feedlot 6 Oil field water supply 9 Dewatering **12 Other (Specify below)**2 Irrigation 4 Industrial 7 Lawn and garden only 10 Monitoring well **Air sparge**Was a chemical/bacteriological sample submitted to Department? Yes.....No ☒; If yes, mo/day/yr sample was submittedWater Well Disinfected? Yes No ☒

5 TYPE OF BLANK CASING USED:

1 Steel 3 RMP (SR)

2 PVC 4 ABS

5 Wrought iron

6 Asbestos-Cement

7 Fiberglass

8 Concrete tile

9 Other (specify below)

CASING JOINTS: Glued Clamped

Welded

Threaded. ☒Blank casing diameter **2** in. to **25** ft. Dia. in. to ft. Dia. in. to ft.Casing height above land surface in., weight lbs./ft. Wall thickness or gauge No. **Sch. 40**

TYPE OF SCREEN OR PERFORATION MATERIAL

1 Steel 3 Stainless steel

2 Brass 4 Galvanized steel

5 Fiberglass

6 Concrete tile

7 PVC

8 RMP (SR)

9 ABS

10 Asbestos-cement

11 Other (specify)

12 None used (open hole)

SCREEN OR PERFORATION OPENINGS ARE:

1 Continuous slot **3 Mill slot**

2 Louvered shutter 4 Key punched

5 Gauzed wrapped

6 Wire wrapped

7 Torch cut

8 Saw cut

9 Drilled holes

10 Other (specify)

11 None (open hole)

SCREEN-PERFORATED INTERVALS: From **25** ft. to **30** ft. From ft. to ft. From ft. to ft.

From ft. to ft. From ft. to ft. From ft. to ft.

GRAVEL PACK INTERVALS: From **23** ft. to **30** ft. From ft. to ft. From ft. to ft.

From ft. to ft. From ft. to ft. From ft. to ft.

6 GROUT MATERIAL:

1 Neat cement

2 Cement grout

3 Bentonite**4 Other Fill Sand**Grout Intervals: From **0** ft. to **3** ft. From **3** ft. to **23** ft. From ft. to ft.

What is the nearest source of possible contamination:

1 Septic tank

4 Lateral lines

7 Pit privy

10 Livestock pens

14 Abandoned water well

2 Sewer lines

5 Cess pool

8 Sewage lagoon

11 Fuel storage

15 Oil well/Gas well

3 Watertight sewer lines

6 Seepage pit

9 Feedyard

12 Fertilizer storage

16 Other (specify below)

13 Insecticide storage

Direction from well?

How many feet?

FROM TO LITHOLOGIC LOG FROM TO PLUGGING INTERVALS

0 4 Clay, v. silty, Dark Brown**4 11.5 Sand fill, vf grained, Tan****11.5 20 Sand, f-c grained, v. silty, Gray****20 30 Gravel, w/f-c grained sand, Tan****IAS-12, Flushmount**7 CONTRACTOR'S OR LANDOWNER'S CERTIFICATION: This water well was **(1)** constructed, (2) reconstructed, or (3) plugged under my jurisdictionand was completed on (mo/day/year) **5/23/2012** and this record is true to the best of my knowledge and belief.Kansas Water Well Contractor's License No. **527** This Water Well Record was completed on (mo/day/yr) **6/16/12**under the business name of **GeoCore, Inc.** by (signature) *Duane*