

1 LOCATION OF WATER WELL: County: Sedgwick	Fraction NW ¼ NE ¼ NE ¼	Section Number 7	Township Number T 28 S	Range Number R 1 E
--	-----------------------------------	----------------------------	----------------------------------	------------------------------

Distance and direction from nearest town or city street address of well if located within city?

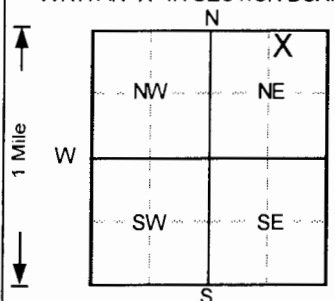
1501 W. 31st St., Wichita2 WATER WELL OWNER: **Richardson & Associates, LLC**RR#, St. Address, Box # : **3021 N. Ridge Port Ct.**

Board of Agriculture, Division of Water Resources

City, State, ZIP Code : **Wichita, Kansas 67205**

Application Number:

3 LOCATE WELL'S LOCATION WITH AN "X" IN SECTION BOX:

4 DEPTH OF COMPLETED WELL: **30** ft. ELEVATION:

Depth(s) Groundwater Encountered 1. ft. 2. ft. 3. ft.

WELL'S STATIC WATER LEVEL ft. below land surface measured on mo/day/yr

Pump test data: Well water was **NA** ft. after hours pumping gpmEst. Yield **NA** gpm: Well water was ft. after hours pumping gpmBore Hole Diameter **8** in. to **30** ft. and in. to ft.

WELL WATER TO BE USED AS: 5 Public water supply 8 Air conditioning 11 Injection well

1 Domestic 3 Feedlot 6 Oil field water supply 9 Dewatering **12 Other (Specify below)**2 Irrigation 4 Industrial 7 Lawn and garden only 10 Monitoring **Air sparge**Was a chemical/bacteriological sample submitted to Department? Yes.....No ☒; If yes, mo/day/yr sample was submittedWater Well Disinfected? Yes No ☒

5 TYPE OF BLANK CASING USED:

1 Steel 3 RMP (SR) 6 Asbestos-Cement 8 Concrete tile CASING JOINTS: Glued Clamped

2 PVC 4 ABS 7 Fiberglass 9 Other (specify below) Welded

Blank casing diameter 2 in. to 25 ft. Dia in. to ft. Dia in. to ft.

Casing height above land surface in., weight lbs./ft. Wall thickness or gauge No. **Sch. 40**

TYPE OF SCREEN OR PERFORATION MATERIAL

1 Steel 3 Stainless steel 5 Fiberglass **7** PVC 10 Asbestos-cement

2 Brass 4 Galvanized steel 6 Concrete tile 9 ABS 11 Other (specify)

SCREEN OR PERFORATION OPENINGS ARE: 5 Gauzed wrapped 8 Saw cut 11 None (open hole)

1 Continuous slot **3** Mill slot 6 Wire wrapped 9 Drilled holes

2 Louvered shutter 4 Key punched 7 Torch cut 10 Other (specify)

SCREEN-PERFORATED INTERVALS: From 25 ft. to 30 ft. From ft. to ft.

GRAVEL PACK INTERVALS: From 23 ft. to 30 ft. From ft. to ft.

From ft. to ft. From ft. to ft.

From ft. to ft. From ft. to ft.

6 GROUT MATERIAL: 1 Neat cement 2 Cement grout **3** Bentonite **4** Other **Fill Sand**

Grout Intervals: From 0 ft. to 3 ft. From 3 ft. to 25 ft. From ft. to ft.

What is the nearest source of possible contamination:

1 Septic tank 4 Lateral lines 7 Pit privy 10 Livestock pens 14 Abandoned water well

2 Sewer lines 5 Cess pool 8 Sewage lagoon 11 Fuel storage 15 Oil well/Gas well

3 Watertight sewer lines 6 Seepage pit 9 Feedyard 12 Fertilizer storage 16 Other (specify below)

Direction from well? How many feet?

FROM TO LITHOLOGIC LOG FROM TO PLUGGING INTERVALS

0 1 Silt, powdery, Dark Gray

1 13 Sand fill, Tan

13 22 Sand, vf-c grained, silty, Gray

22 30 Gravel, w/f-c grained, Brown

OFFICE USE ONLY

T

R

EW

SEC.

¼

¼

¼