

County: Sedgwick Fraction NE SE SE NW Sec. 9 T 28 S R 1 (E)W

CORRECTION(S) TO WATER WELL COMPLETION RECORD (WWC-5)
(to rectify lacking or incorrect information)

Owner: Billy Williamson Estate

Location was listed as:

Section-Township-Range: None Given

Fraction ($\frac{1}{4}$ $\frac{1}{4}$ $\frac{1}{4}$): _____

Location changed to:

9-28 S-1 E

NE SE SE NW

Other changes: Initial statements: _____

Changed to: _____

Comments: _____

Verification method: well site address, city street map, and mapping tool on KGS website.

initials: DRd date: 10/2/2012

Submitted by: Kansas Geological Survey, Data Resources Library, 1930 Constant Ave., Lawrence, KS 66047-3726
to: Kansas Dept of Health & Environment, Bureau of Water, 1000 SW Jackson, Suite 420, Topeka, KS 66612-1367.

Stephen and Marta Williamson
1216 W. 71 Terrace
Kansas City MO 64114
816-333-8723

August 19, 2012

Kansas Department of Health and Environment
Bureau of Water, Geology Section
1000 SW Jackson Street, Ste 420
Topeka KS 66612-1367


To Whom it Concerns:

My parents, Billy and Betty Williamson had a well at their house at 3414 South Ida in Wichita, Kansas 67216. My father put in a sand point on the north side of the house, adjacent to the garage in about 1960. This was used to water the lawn. He stopped using the well over 15 years ago, but never removed the pump or sand point. He died on August 16, 2011 and my mother died on July 22, 2012. We are selling the house and since the well was not functioning, plugged it on August 18, 2012.

We removed as much of the sand point as we could – about 8 feet of pipe, the pipe broke and the rest remains below ground. Prior to removing the pipe, we dropped a weighted string that went about 10 feet, the stopped. No water was encountered. We then poured a gallon of bleach in the hole. Next we removed the sand point pipe as noted. There was about a 2 inch diameter hole, which we filled with sand. We then covered the area with concrete (about 5 inches deep) so that the area was flush with the surrounding patio concrete.

I have completed the form WWC-5P as completely as I could. If you need further information, please let me know.

Thank you,

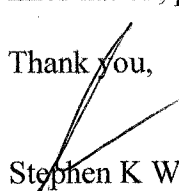
Stephen K Williamson

WATER WELL PLUGGING RECORD

Form WWC-5P

KSA 82a-1212

ID NO.

1 LOCATION OF WATER WELL:	Fraction	Section Number	Township Number	Range Number
County: Sedgwick	1/4 1/4 1/4 1/4		T S	E W

Street/Rural Address of Well Location; if unknown, distance & direction from nearest town or intersection: If at owner's address, check here ☒ 3414 South Ida, Wichita, KS

Global Positioning Systems (GPS) information:

Latitude: _____ (in decimal degrees)

Longitude: _____ (in decimal degrees)

Elevation: _____

Datum: ☐ WGS84, ☐ NAD83, ☐ NAD27

Collection Method:


☐ GPS unit (Make/Model: _____)

☐ Digital Map/Photo, ☐ Topographic Map, ☐ Land Survey

Est. Accuracy: ☐ < 3 m, ☐ 3-5 m, ☐ 5-15 m, ☐ > 15 m

2 WATER WELL OWNER: Billy Williamson Estate
RR#, St. Address, Box #: 3414 South Ida St.
City, State ZIP Code: Wichita, KS 67216

3 MARK WELL'S LOCATION WITH AN "X" IN SECTION BOX:

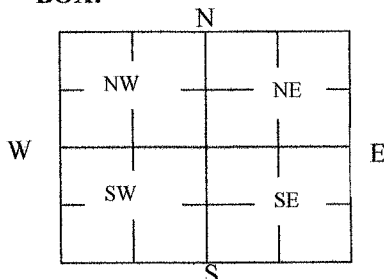

4 DEPTH OF WELL 10 ft.

WELL'S STATIC WATER LEVEL 0 ft

WELL WAS USED AS:

☐ Domestic
☐ Irrigation
☐ Feedlot
☐ Industrial

☐ Public Water Supply
☐ Oil Field Water Supply
☒ Domestic (Lawn & Garden)
☐ Air Conditioning

☐ Dewatering
☐ Monitoring
☐ Injection Well
☒ Other Nonfunctiona

Was a chemical/bacteriological sample submitted to Department? Yes ☐ No ☒

5 TYPE OF BLANK CASING USED:

☒ Steel
☐ PVC

☐ RMP (SR)
☐ ABS

☐ Wrought
☐ Asbestos-Cement

☐ Fiberglass
☐ Concrete Tile

☐ Other (Specify below) _____

Blank casing diameter 2 in. Was casing pulled? Yes ☒ No ☐ If yes, how much Sand Point removed

Casing height above or below land surface 0 in.

6 GROUT PLUG MATERIAL:

☒ Neat cement

☐ Cement grout

☐ Bentonite

☐ Other _____

Grout Plug Intervals: From _____ ft. to _____ ft., From _____ ft. to _____ ft., From _____ to _____ ft.

What is the nearest source of possible contamination:

☐ Septic tank
☒ Sewer lines
☒ Watertight sewer lines
☐ Lateral lines
☐ Cess pool

☐ Seepage pit
☐ Pit privy
☐ Sewage lagoon
☐ Feedyard
☐ Livestock pens

☐ Fuel Storage
☐ Fertilizer storage
☐ Insecticide storage
☐ Abandoned water well
☐ Oil well/Gas well

☐ Other (specify below) _____

Direction from well? South

How many feet? 25

FROM	TO	PLUGGING MATERIALS	FROM	TO	PLUGGING MATERIALS
0'	10'	Hole filled with sand	0	6"	Cement to level with surrounding
		<i>see attached letter</i>			concrete
		The well had not been used for over			We dropped a weight tied to string
		10 years. Sand Point well install			& went to 10' and stopped - no
		around 1960. We removed sand			water. After removal, small hole
		point - or as much as could be			filled with dirt, then area covered
		retrieved.			w/concrete, level with surrounding

7 CONTRACTOR'S OR LANDOWNER'S CERTIFICATION: This water well was plugged under my jurisdiction and was completed on (mo/day/year) 8/18/2012 and this record is true to the best of my knowledge and belief. Kansas Water Well Contractor's License No. _____ This Water Well Record was completed on (mo/day/year) 8/19/2012 under the business name of *Stephen Williamson* by (signature) _____

INSTRUCTIONS: Use typewriter or ballpoint pen. Please press firmly and print clearly. Please fill in blanks, underline or circle the correct answers. Send top three copies to Kansas Department of Health and Environment, Bureau of Water, Geology Section, 1000 SW Jackson St., Ste. 420, Topeka, Kansas 66612-1367. Telephone: 785/296-5524. Send one to Water Well Owner and retain one for your records. Visit us at <http://www.kdheks.gov/waterwell/index.html>.

Check one:

☒ White Copy

☒ Blue Copy

☐ Pink Copy