

WATER WELL PLUGGING RECORD Form WWC-5P

KSA 82a-1212 ID NO.

1 LOCATION OF WATER WELL: Fraction SE NE SW NE Section Number 16 Township Number 28 Range Number 1 W
 County: SEDGWICK NW $\frac{1}{4}$ $\frac{1}{4}$ $\frac{1}{4}$

Distance and direction from nearest town or city street address of well if located within city?

4254 S. Pattie Circle

2 WATER WELL OWNER: Anthony Lutz
 RR#, St. Address, Box #: 4254 S. Pattie Cir.
 City, State ZIP Code: Wichita, KS 67216

Global Positioning Systems (decimal degrees, min. of 4 digits)

Latitude: _____

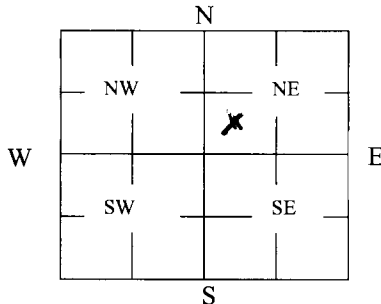
Longitude: _____

Elevation: _____

Datum: _____

Data Collection Method: _____

3 MARK WELL'S LOCATION
WITH AN "X" IN SECTION
BOX:

4 DEPTH OF WELL 25' 6" XWELL'S STATIC WATER LEVEL 15' 8" X

WELL WAS USED AS:

- 1 Domestic
~~2~~ Irrigation
 3 Feedlot
 4 Industrial

- 5 Public Water Supply
 6 Oil Field Water Supply
~~7~~ Domestic (Lawn & Garden)
 8 Air Conditioning

- 9 Dewatering
 10 Monitoring
 11 Injection Well
 12 Other _____

Was a chemical/bacteriological sample submitted to Department? Yes _____ No X

5 TYPE OF BLANK CASING USED:

- 1 Steel 3 RMP (SR) 5 Wrought 7 Fiberglass 9 Other (Specify below)
~~2~~ PVC 4 ABS 6 Asbestos-Cement 8 Concrete Tile

Blank casing diameter 5 in. Was casing pulled? Yes _____ No X If yes, how much _____
 Casing height above or below land surface 48 in.

6 GROUT PLUG MATERIAL: 1 Neat cement 2 Cement grout 3 Bentonite 4 Other _____

Grout Plug Intervals: From 15 ft. to 4 ft., From 4 ft. to 0 ft., From _____ to _____ ft.

What is the nearest source of possible contamination:

- 1 Septic tank 6 Seepage pit 11 Fuel Storage 16 Other (specify below)
~~2~~ Sewer lines 7 Pit privy 12 Fertilizer storage
 3 Watertight sewer lines 8 Sewage lagoon 13 Insecticide storage
 4 Lateral lines 9 Feedyard 14 Abandoned water well Direction from well? WEST
 5 Cess pool 10 Livestock pens 15 Oil well/Gas well How many feet? 9

FROM	TO	PLUGGING MATERIALS	FROM	TO	PLUGGING MATERIALS
<u>15'</u>	<u>4'</u>	<u>Neat Cement</u>			
<u>4'</u>	<u>0'</u>	<u>Fill Dirt / TOP SOIL</u>			

7 CONTRACTOR'S OR LANDOWNER'S CERTIFICATION: This water well was plugged under my jurisdiction and was completed on (mo/day/year) 01/18/2013 and this record is true to the best of my knowledge and belief. Kansas Water Well Contractor's License No. N/A - Home Owner This Water Well Record was completed on (mo/day/year) 01/23/2013 under the business name of N/A by (signature) Anthony Lutz

INSTRUCTIONS: Use typewriter or ballpoint pen. Please press firmly and print clearly. Please fill in blanks, underline or circle the correct answers. Send top three copies to Kansas Department of Health and Environment, Bureau of Water, Geology Section, 1000 SW Jackson St., Ste. 420, Topeka, Kansas 66612-1367. Telephone: 785/296-5522 Send one to Water Well Owner and retain one for your records. Visit us at <http://www.kdheks.gov/geo/waterwells>. 11/10/2013

state