County: Sedgwick Fraction SE NW NW NW Sec. 8 T 28 S R 1 (E)W

CORRECTION(S) TO WATER WELL COMPLETION RECORD (WWC-5)
(to rectify lacking or incorrect information)

Owner: Meghan Smith

Location was listed as:

Section-Township-Range: None Given

Fraction (¼ ¼ ¼):

Location changed to:

8 - 28 S - 1 E

SE NW NW NW

Other changes: Initial statements:

Changed to:

Comments: Earlier faxed form said: "60 ft. east of Walnut St."

Verification method: Latitude & longitude, KGS' "LEO" conversion tool, wellsite address & city street map, and mapping tool on KGS website.

Submitted by: Kansas Geological Survey, Data Resources Library, 1930 Constant Ave., Lawrence, KS 66047-3726 initials: DRL date: 11/25/2013
to: Kansas Dept of Health & Environment, Bureau of Water, 1000 SW Jackson, Suite 420, Topeka, KS 66612-1367.

WATER WELL PLUGGING RECORD Form WWC-5P KSA 82a-1212 ID NO.

1 LOCATION OF WATER WELL: County: Sedgwick | Fraction: ¼ ¼ ¼ ¼ | Section Number | Township Number T S | Range Number ☐ E ☐ W

Street/Rural Address of Well Location; if unknown, distance & direction from nearest town or intersection: If at owner's address, check here ☒

Global Positioning Systems (GPS) information:
Latitude: 37.6353 (in decimal degrees)
Longitude: -97.3511 (in decimal degrees)
Elevation:
Datum: ☒ WGS84, ☐ NAD83, ☐ NAD27
Collection Method:
☐ GPS unit (Make/Model:)
☒ Digital Map/Photo, ☐ Topographic Map, ☐ Land Survey
Est. Accuracy: ☐ < 3 m, ☒ 3-5 m, ☐ 5-15 m, ☐ > 15 m

2 WATER WELL OWNER: Meghan Smith
RR#, St. Address, Box #: 3252 S Walnut St
City, State ZIP Code: Wichita KS 67217

3 MARK WELL'S LOCATION WITH AN "X" IN SECTION BOX:

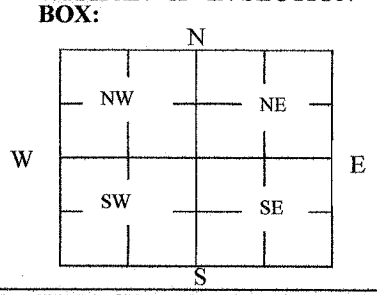

4 DEPTH OF WELL 20 ft.
WELL'S STATIC WATER LEVEL 12 ft
WELL WAS USED AS:

☐ Domestic	☐ Public Water Supply	☐ Dewatering
☐ Irrigation	☐ Oil Field Water Supply	☐ Monitoring
☐ Feedlot	☒ Domestic (Lawn & Garden)	☐ Injection Well
☐ Industrial	☐ Air Conditioning	☐ Other

Was a chemical/bacteriological sample submitted to Department? Yes ☐ No ☒

5 TYPE OF BLANK CASING USED:

☐ Steel	☐ RMP (SR)	☐ Wrought	☐ Fiberglass	☐ Other (Specify below)
☒ PVC	☐ ABS	☐ Asbestos-Cement	☐ Concrete Tile	

Blank casing diameter 6 in. Was casing pulled? Yes ☐ No ☒ If yes, how much
Casing height above or below land surface 36 in.

6 GROUT PLUG MATERIAL: ☐ Neat cement ☒ Cement grout ☐ Bentonite ☐ Other

Grout Plug Intervals: From 0 ft. to 16 ft., From 16 ft. to 4 ft., From 4 ft. to 0 ft.

What is the nearest source of possible contamination:

☐ Septic tank	☐ Seepage pit	☐ Fuel storage	☐ Other (specify below)
☒ Sewer lines	☐ Pit privy	☐ Fertilizer storage	
☐ Watertight sewer lines	☐ Sewage lagoon	☐ Insecticide storage	
☐ Lateral lines	☐ Feedyard	☐ Abandoned water well	Direction from well? South
☐ Cess pool	☐ Livestock pens	☐ Oil well/Gas well	How many feet? 8

FROM	TO	PLUGGING MATERIALS	FROM	TO	PLUGGING MATERIALS
00'	16'	mortar mix			
16'	4'	quick crete			
4'	00'	quick crete			

7 CONTRACTOR'S OR LANDOWNER'S CERTIFICATION: This water well was plugged under my jurisdiction and was completed on (mo/day/year) 7/13/13 and this record is true to the best of my knowledge and belief. Kansas Water Well Contractor's License No. . This Water Well Record was completed on (mo/day/year) 7/13/13 under the business name of N/A - home owner by (signature) Meghan Smith

INSTRUCTIONS: Use typewriter or ballpoint pen. Please press firmly and print clearly. Please fill in blanks, underline or circle the correct answers. Send top three copies to Kansas Department of Health and Environment, Bureau of Water, Geology Section, 1000 SW Jackson St., Ste. 420, Topeka, Kansas 66612-1367. Telephone: 785/296-5524. Send one to Water Well Owner and retain one for your records. Visit us at http://www.kdheks.gov/waterwell/index.html.