


**WATER WELL RECORD Form WWC-5 KSA 82a-1212**

1 LOCATION OF WATER WELL: <b>Sedgwick</b>	FRACTION <b>SE 1/4 SW 1/4 SW 1/4</b>	SECTION NUMBER <b>23</b>	TOWNSHIP NUMBER <b>T 28 S</b>	RANGE NUMBER <b>R 1E E/W</b>
--	---	-----------------------------	----------------------------------	---------------------------------

Distance and direction from nearest town or city street address of well if located within city?  
**5550 Meadow View Wichita, Kansas 67216**

2 WATER WELL OWNER: <b>KLAUSMEYER CONSTRUCTION</b>	Board of Agriculture, Division of Water Resource
RR#,ST. ADDRESS,BOX #: <b>10008 W.York</b>	Application Number:
CITY, STATE: <b>Wichita, Kansas</b>	ZIP CODE:

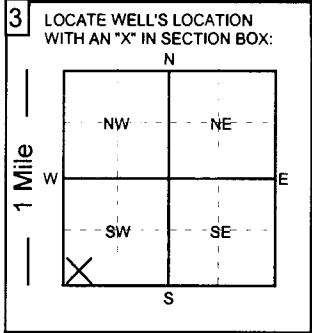

4 DEPTH OF COMPLETED WELL: <b>35</b> ft.	ELEVATION:
Depth of groundwater Encountered:	ft.
WELL'S STATIC WATER LEVEL <b>10</b> FT. BELOW LAND SURFACE MEASURED ON <b>6/4/14</b>	
Pump test data: Well water was	ft. after hours of pumping @ gpm
Est. Yield: gpm	Well water was ft. after hours of pumping @ gpm
Bore Hole Diameter <b>12</b> in.	to <b>35</b> ft. and in. to ft.
WELL WATER TO BE USED AS:	
1. Domestic 3. Feedlot 5. Public water supply	7. <u>Lawn and garden only</u> 9. Dewatering 11. Injection well
2. Irrigation 4. Industrial 6. Oil field water supply	8. Air conditioning 10. Monitoring well 12. Other (Specify below)
Was a chemical/bacteriological sample submitted to Department?	<b>YES</b> <u>NO</u> ; If yes, what mo/day/yr was sample submitted
Was Water Well Disinfected?	<u>YES</u> <b>NO</b>

5 TYPE OF CASING USED:	1. Steel 3. RPM (SR) 5. Wrought Iron 7. Fiberglass 9. Other (Specify below)	CASING JOINTS:	<u>Glued</u> Threaded Welded Clamped
<u>2. PVC</u> 4. ABS 6. Asbestos-Cement 8. Concrete tile	SDR-26		
Blank casing diameter <b>5</b> in.	to <b>24</b> ft., Dia.	in. to ft., Dia.	in. to ft.
Casing height above land surface: <b>12</b> in.,	Weight: <b>2.35</b> lbs. / ft.	Wall thickness or gauge No. <b>.214</b>	
TYPE OF SCREEN OR PERFORATION MATERIAL:			
1. Steel 3. Stainless Steel 5. Fiberglass <u>7. PVC</u>	9. ABS 11. Other (specify)		
2. Brass 4. Galvanized 6. Concrete Tile 8. RMP (SR)	10. Asbestos-Cement 12. None used (open hole)		
SCREEN OR PERFORATION OPENINGS ARE:			
1. Continuous slot 3. Mill slot 5. Gauzed wrapped 7. Torch cut 9. Drilled holes 11. None ( open hole)			
2. Louvered shutter 4. Key punched 6. Wire wrapped <u>8. Saw cut</u> 10. Other (specify)			
SCREEN - PERFORATION INTERVAL	From <b>24</b> ft. to <b>35</b> ft.,	From ft. to ft.	ft.
GRAVEL PACK INTERVALS:	From <b>24</b> ft. to <b>35</b> ft.,	From ft. to ft.	ft.

6 GROUT MATERIALS:	1. Neat cement 2. Cement Grout 3. Bentonite Other <b>bentonite hole plug</b>
Grout Intervals: From <b>4</b> ft. to <b>24</b> ft.,	From ft. to ft., From ft. to ft.
What is the nearest source of possible contamination:	
1. Septic tank 4. Lateral lines 7. Pit privy 10. Livestock pens 13. Insecticide storage 15. Oil well/Gas well	
2. Sewer lines 5. Cess Pool 8. Sewage lagoon 11. Fuel storage 14. Abandon water well 16. Other (specify below)	
<u>3. Watertight sewer line</u> 6. Seepage pit 9. Feed yard 12. Fertilizer storage	
Direction from well? <b>East</b>	How many feet? <b>10 ft. plus</b>

From	To	LITHOLOGIC LOG	From	To	LITHOLOGIC LOG
0	3	topsoil			
3	8	clay			
8	22	fine sand			
22	35	gray shale			

7 Contractor's or Landowner's Certification: This water well was 1. <u>constructed</u> 2. reconstructed or 3. plugged under my jurisdiction and was completed on (mo/day/year) <b>6/4/2014</b> and this record is true to the best of my knowledge and belief.
Kansas Water Well Contractor's License No. 236 This water well record was completed on (mo/day/year) <b>6/6/2014</b>
under the business name of <b>Harp Well and Pump Service</b> by (signature) <b>Todd S. Harp</b>