


**3800 S. Oliver St. – Wichita**

Application Number:

**15** ft. ELEVATION:

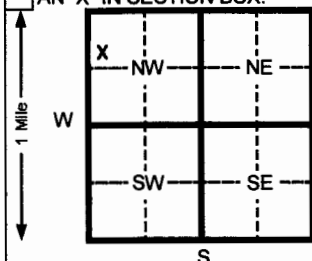

Was a chemical/bacteriological sample submitted to Department? Yes \_\_\_\_\_ No ☒ If yes, mo/day/yr sample was submitted \_\_\_\_\_

Water/Well Disinfected? Yes \_\_\_\_\_ No ☒

**How many feet?**

FROM	TO	CODE	LITHOLOGIC LOG	FROM	TO	PLUGGING INTERVALS
0	5		<b>Silty Clay</b> , dark brown to brown, some fine to medium sand and caliche below 3.5'			
5	11		<b>Sandy Clay</b>			
11	11.75		<b>Sandy Clay/Clayey Sand</b>			
11.75	13		<b>Sandy Clay</b> , with caliche gravel			
13	14		<b>Sand</b> , with some clay			
14	15		<b>Clayey Sand</b>			
15	16		<b>Weathered Shale</b> , olive			
						<b>GPS: NAD83</b>
						<b>Latitude: N 37.632342</b>
						<b>Longitude: W 97.278711</b>

under the business name of **GSI Engineering, LLC** by (signature) *David W. [illegible]*

**INSTRUCTIONS:** Please fill in blanks and circle the correct answers. Send three copies to Kansas Department of Health and Environment, Bureau of Water, 1000 S W Jackson St., Ste. 420, Topeka, Kansas 66612-1367. Telephone: 913-296-5545. Send one to WATER WELL OWNER and retain one for your records.