

County: Sedgwick Fraction NW SW SE SW Sec. 6 T 28 S R 1 EAW

CORRECTION(S) TO WATER WELL COMPLETION RECORD (WWC-5)
(to rectify lacking or incorrect information)

Owner: _____

Location was listed as:

Section-Township-Range: 6-285-1E

Fraction (1/4 1/4 1/4): None Given

Location changed to:

6-285-1E

NW SW SE SW

Other changes: Initial statements: _____

Changed to: _____

Comments: _____

Verification method: Well owners address, city street map, and
Mapping tool on KGS website

initials: JF^(DRL) date: 12/28/2015

Submitted by: Kansas Geological Survey, Data Resources Library, 1930 Constant Ave., Lawrence, KS 66047-3726
to: Kansas Dept of Health & Environment, Bureau of Water, 1000 SW Jackson, Suite 420, Topeka, KS 66612-1367.

Sta 6

WATER WELL PLUGGING RECORD Form WWC-5P KSA 82a-1212 ID NO. []


1 LOCATION OF WATER WELL: County: Sedgwick Fraction 1/4 1/4 1/4 Section Number 6 Township Number 285 Range Number 1 E/W

Distance and direction from nearest town or city street address of well if located within city?

2 WATER WELL OWNER: Wade Hoagboon RR#, St. Address, Box #: 3116 S Bennett Ave City, State ZIP Code: Wichita, KS 67217

Global Positioning Systems (decimal degrees, min. of 4 digits) Latitude: Longitude: Elevation: Datum: Data Collection Method:

3 MARK WELL'S LOCATION WITH AN "X" IN SECTION BOX:

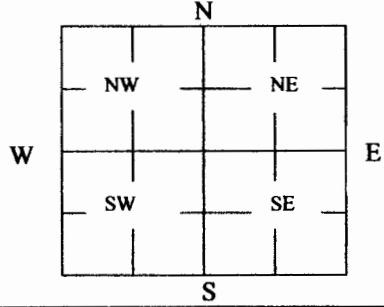

4 DEPTH OF WELL 15 ft.

WELL'S STATIC WATER LEVEL _____ ft

WELL WAS USED AS:

- 1 Domestic 2 Irrigation 3 Feedlot 4 Industrial 5 Public Water Supply 6 Oil Field Water Supply 7 Domestic (Lawn & Garden) 8 Air Conditioning 9 Dewatering 10 Monitoring 11 Injection Well 12 Other

Was a chemical/bacteriological sample submitted to Department? Yes No

5 TYPE OF BLANK CASING USED:

- 1 Steel 2 PVC 3 RMP (SR) 4 ABS 5 Wrought 6 Asbestos-Cement 7 Fiberglass 8 Concrete Tile 9 Other (Specify below)

Blank casing diameter 2 in. Was casing pulled? Yes X No If yes, how much 3 ft Casing height above or below land surface 36 in.

6 GROUT PLUG MATERIAL: 1 Neat cement 2 Cement grout 3 Bentonite 4 Other

Grout Plug Intervals: From _____ ft. to _____ ft., From _____ ft. to _____ ft., From _____ to _____ ft.

What is the nearest source of possible contamination:

- 1 Septic tank 2 Sewer lines 3 Watertight sewer lines 4 Lateral lines 5 Cess pool 6 Seepage pit 7 Pit privy 8 Sewage lagoon 9 Feedyard 10 Livestock pens 11 Fuel Storage 12 Fertilizer storage 13 Insecticide storage 14 Abandoned water well 15 Oil well/Gas well 16 Other (specify below) Sump pump Direction from well? South How many feet? 1

Table with columns: FROM, TO, PLUGGING MATERIALS. Row 1: Top, Bottom, Bentonite/Cement.

7 CONTRACTOR'S OR LANDOWNER'S CERTIFICATION: This water well was plugged under my jurisdiction and was completed on (mo/day/year) 7/16/15 and this record is true to the best of my knowledge and belief. Kansas Water Well Contractor's License No. 1611. This Water Well Record was completed on (mo/day/year) 7/21/15 under the business name of Chase Drilling LLC by (signature) Wade Hoagboon

INSTRUCTIONS: Use typewriter or ballpoint pen. Please press firmly and print clearly. Please fill in blanks, underline or circle the correct answers. Send top three copies to Kansas Department of Health and Environment, Bureau of Water, Geology Section, 1000 SW Jackson St., Ste. 420, Topeka, Kansas 66612-1367. Telephone: 785/296-5522. Send one to Water Well Owner and retain one for your records. Visit us at http://www.kdheks.gov/geo/waterwells.