

WATER WELL RECORD

Form WWC-5

Division of Water Resources App. No.


Well ID

MW1

Original Record- Correction Change in Well Ust

1 LOCATION OF WATER WELL: County Sedgwick Fraction SW 1/4 SW 1/4 SE 1/4 SE 1/4 Section Number 3 Township Number T 28 S Range Number R 1 E W

2 WELL OWNER: Last Name: Wayman Business: Address: 548 E Main City Mulvane State KS ZIP: 67110 Street or Rural Address where well is located (if unknown, distance and direction from nearest town or intersection): 3150 Southeast Blvd., Wichita KS

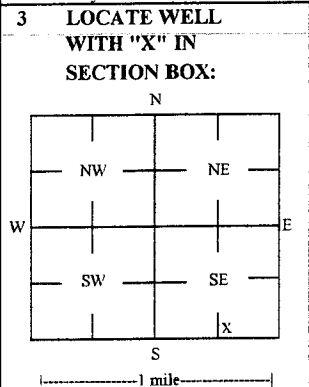

4 DEPTH OF COMPLETED WELL: 29.7 ft Depth(s) Groundwater Encountered: 1) 29.7 ft 2) 3) 4) Dry Well WELL'S STATIC WATER LEVEL: 20.33 ft

5 Latitude: 37.63539 (decimal degrees) Longitude: 97.30299 (decimal degrees) Horizontal Datum: X WGS 84 NAD 83 NAD 27 Source for Latitude/Longitude: X Land Survey

6 Elevation: 1282.73 ft Ground Level: X TOC Source: X Land Survey GPS Topographic Map Other

7 WELL WATER TO BE USED AS: 1 Domestic: Household Lawn & Garden Livestock Irrigation Feedlot Industrial 2 Public Water Supply: well ID 3 Dewatering: how many wells? 4 Aquifer Recharge: well ID 5 Monitoring: well ID MW1 6 Environmental Remediation: well ID Air Sparge Soil Vapor Extractor Recovery 7 Oil Field Water Supply: lease 8 Test Hole: well ID Cased Uncased Geotechnical 9 Geothermal: How many bores? a) Closed Loop Horizontal Vertical b) Open Loop Surface Discharge Inj. of Water Other (specify):

Was a chemical/bacteriological sample submitted to KDHE? Yes No X No If yes, date sample was submitted: Water well disinfected? Yes No X No

8 TYPE OF CASING USED: Steel PVC Other CASING JOINTS: Glued Clamped Welded X Threaded Casing diameter 2 in. to 14.7 ft, Diameter in. to ft, Diameter in. to ft, Casing height above land surface -0.45 in. Weight lbs./ft. Well thickness or gauge No TYPE OF SCREEN OR PERFORATION MATERIAL: Steel Stainless Steel Fiberglass PVC Other (Specify) SCREEN OR PERFORATION OPENINGS ARE: Continuous Slot X Mill Slot Gauze Wrapped Torch Cut Drilled Holes Other (Specify) Louvered Shutter Key Punched Wire Wrapped Saw Cut None (Open Hole) SCREEN-PERFORATED INTERVALS: From 14.7 ft. to 29.7 ft. GRAVEL PACK INTERVALS: From 13 ft. to 30 ft.

9 GROUT MATERIAL: Neat cement Cement grout X Bentonite X Other Concrete: 0-1' Grout intervals: From 1 ft. to 30 ft. From ft. to ft. From ft. to ft.

Nearest source of possible contamination: Septic Tank Lateral Lines Pit Privy Livestock Pens Insecticide Storage Sewer Lines Cess Pool Sewage Lagoon X Fuel Storage Abandoned Water Well Watertight Sewer Lines Seepage Pit Feedyard Fertilizer Storage Oil Well / Gas Well Other (Specify) Direction from well? W Distance from well? ~5 ft

10 FROM TO LITHOLOGIC LOG FROM TO LITHO. LOG (cont.) or PLUGGING INTERVALS

0	1	Concrete and gravel			
1	10	Brown to dark brown silty clay			
10	15	Dark brown silty clay grading to brown very fine sand			
15	20	Very fine to fine brown to dark brown sand			
20	29	Brown to gray medium sand			
29	30	Dark gray silty clay			

Notes: KDHE ID: L Wayne Wayman; U2-087-14692

11 CONTRACTOR'S OR LANDOWNER'S CERTIFICATION: This water well was X constructed, reconstructed, or plugged under my jurisdiction and was completed on (mo-day-year) 9/28/15 and this record is true to the best of my knowledge and belief. Kansas Water Well Contractor's License No 757 This Water Well Record was completed on (mo-day-year) 1/6/16 under the business name of Larsen & Associates, Inc. Signature

Mail 1 white copy along with a fee of \$5.00 for each constructed well to: Kansas Department of Health and Environment, Bureau of Water, GWTS Section, 1000 SW Jackson St., Suite 420, Topeka, Kansas 66612-1367. Mail one to Water Well Owner and retain one for your records. Telephone 785-296-5524.

TRITERRA

LAND SERVICES

P.O. Box 546
Clearwater, Kansas 67026
Cell (316) 648-3617 Fax (620) 584-4371
E-mail: triterrals@yahoo.com

SURVEYING OF MONITORING WELLS
L. WAYNE WAYMAN
3150 SOUTHEAST BLVD.
WICHITA, KANSAS

The above site is located in Section 3, Township 28 South, Range 1 East of the Sixth Principal Meridian, Sedgwick County, Kansas. The Southeast corner of Section 3 was assigned coordinates of 00.00 North and 00.00 West.

The vertical control was obtained from the City of Wichita, described as a chiseled square on top of the headwall of a culvert at the northwest corner of the new QuikTrip property south of the site and 31st Street. Elevation: 1283.71. A control point was established as a chiseled 'X' at the interior northwest corner of the fenced enclosure on site.

The Latitude and Longitude were recorded from a GPS unit. The site is located on the 7.5' quad map titled "Wichita East".

ID	NORTH	WEST	LATITUDE	LONGITUDE	ELEVATION
SE CORNER 3-T28S-R1E	00.00	00.00			
CP	138.20	1275.08	37.63537	97.30328	1283.46
MW-1 SW SW SE SE	150.33	1195.82	37.63539	97.30299	RIM 1283.18 TOC 1282.73
MW-2 SW SW SE SE	185.93	1111.73	37.63551	97.30271	RIM 1283.17 TOC 1282.67
MW-3 SW SW SE SE	140.91	1260.49	37.63538	97.30325	RIM 1283.45 TOC 1283.17
MW-4 SW SW SE SE	243.09	1299.47	37.63566	97.30335	RIM 1283.32 TOC 1282.90
MW-5 SW SW SE SE	124.52	1113.22	37.63533	97.30273	RIM 1283.42 TOC 1282.82
MW-6 SW SW SE SE	87.70	1224.75	37.63523	97.30312	RIM 1283.29 TOC 1283.03
MW-7 SW SW SE SE	82.42	1178.56	37.63521	97.30295	RIM 1283.22 TOC 1282.91
MW-8 SE SE SW SE	277.64	1360.49	37.63575	97.30358	RIM 1283.29 TOC 1282.85
MW-9 SW SW SE SE	309.21	1231.07	37.63583	97.30312	RIM 1282.80 TOC 1282.35

