

WATER WELL RECORD

Form WWC-5

Division of Water Resources App. No.


Well ID

MW2

Original Record Correction Change in Well Ust

1 LOCATION OF WATER WELL: County Sedgwick Fraction SW 1/4 SW 1/4 SE 1/4 SE 1/4 Section Number 3 Township Number T 28 S Range Number R 1 E W

2 WELL OWNER: Last Name: Wayman First: L. Wayne Street or Rural Address where well is located (if unknown, distance and direction from nearest town or intersection): If at owner's address, check here: ~50' E of 3150 Southeast Blvd., Wichita KS

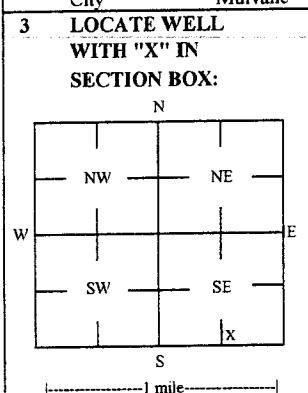

3 LOCATE WELL WITH 'X' IN SECTION BOX: 4 DEPTH OF COMPLETED WELL: 29.6 ft Depth(s) Groundwater Encountered: 1) _____ ft 2) _____ ft 3) _____ ft, or 4) Dry Well

5 Latitude: 37.63551 (decimal degrees) Longitude: 97.30271 (decimal degrees) Horizontal Datum: [X] WGS 84 [] NAD 83 [] NAD 27

7 WELL WATER TO BE USED AS: 1 Domestic: [] Household [] Lawn & Garden [] Livestock [] Irrigation [] Feedlot [] Industrial 5 Public Water Supply: well ID 6 Dewatering: how many wells? 7 Aquifer Recharge: well ID 8 [X] Monitoring: well ID MW2 9 Environmental Remediation: well ID

Was a chemical/bacteriological sample submitted to KDHE? [] Yes [X] No If yes, date sample was submitted: Water well disinfected? [] Yes [X] No

8 TYPE OF CASING USED: [] Steel [X] PVC [] Other CASING JOINTS: [] Glued [] Clamped [] Welded [X] Threaded Casing diameter 2 in. to 14.6 ft, Diameter _____ in. to _____ ft, Diameter _____ in. to _____ ft, Casing height above land surface -0.5 in. Weight _____ lbs./ft. Well thickness or gauge No _____

9 GROUT MATERIAL: [] Neat cement [] Cement grout [X] Bentonite [X] Other Concrete: 0-1' Grout intervals: From 1 ft. to 30 ft, From _____ ft. to _____ ft, From _____ ft. to _____ ft.

Nearest source of possible contamination: [] Septic Tank [] Lateral Lines [] Pit Privy [] Livestock Pens [] Insecticide Storage [] Sewer Lines [] Cess Pool [] Sewage Lagoon [X] Fuel Storage [] Abandoned Water Well [] Watertight Sewer Lines [] Seepage Pit [] Feedyard [] Fertilizer Storage [] Oil Well / Gas Well [] Other (Specify) _____

10 FROM TO LITHOLOGIC LOG FROM TO LITHO. LOG (cont.) or PLUGGING INTERVALS

0	0.5	Topsoil			
0.5	5	Dark brown silty clay			
5	12.5	Brown and gray silty clay			
12.5	14	Sand with silt			
14	15	Brown and gray silty clay			
15	20	Tan to brown and gray medium sand			
20	25	Brown sand w/ pebbles to gravel			
25	29	Brown to gray sand and pebbles			
29	30	Gray silty clay			

Notes: KDHE ID: L Wayne Wayman; U2-087-14692

11 CONTRACTOR'S OR LANDOWNER'S CERTIFICATION: This water well was [X] constructed, [] reconstructed, or [] plugged under my jurisdiction and was completed on (mo-day-year) 9/30/15 and this record is true to the best of my knowledge and belief. Kansas Water Well Contractor's License No 757 This Water Well Record was completed on (mo-day-year) 1/6/16 under the business name of Larsen & Associates, Inc. Signature _____

TRITERRA

LAND SERVICES

P.O. Box 546
Clearwater, Kansas 67026
Cell (316) 648-3617 Fax (620) 584-4371
E-mail: triterrals@yahoo.com

SURVEYING OF MONITORING WELLS
L. WAYNE WAYMAN
3150 SOUTHEAST BLVD.
WICHITA, KANSAS

The above site is located in Section 3, Township 28 South, Range 1 East of the Sixth Principal Meridian, Sedgwick County, Kansas. The Southeast corner of Section 3 was assigned coordinates of 00.00 North and 00.00 West.

The vertical control was obtained from the City of Wichita, described as a chiseled square on top of the headwall of a culvert at the northwest corner of the new QuikTrip property south of the site and 31st Street. Elevation: 1283.71. A control point was established as a chiseled 'X' at the interior northwest corner of the fenced enclosure on site.

The Latitude and Longitude were recorded from a GPS unit. The site is located on the 7.5' quad map titled "Wichita East".

ID	NORTH	WEST	LATITUDE	LONGITUDE	ELEVATION
SE CORNER 3-T28S-R1E	00.00	00.00			
CP	138.20	1275.08	37.63537	97.30328	1283.46
MW-1 SW SW SE SE	150.33	1195.82	37.63539	97.30299	RIM 1283.18 TOC 1282.73
MW-2 SW SW SE SE	185.93	1111.73	37.63551	97.30271	RIM 1283.17 TOC 1282.67
MW-3 SW SW SE SE	140.91	1260.49	37.63538	97.30325	RIM 1283.45 TOC 1283.17
MW-4 SW SW SE SE	243.09	1299.47	37.63566	97.30335	RIM 1283.32 TOC 1282.90
MW-5 SW SW SE SE	124.52	1113.22	37.63533	97.30273	RIM 1283.42 TOC 1282.82
MW-6 SW SW SE SE	87.70	1224.75	37.63523	97.30312	RIM 1283.29 TOC 1283.03
MW-7 SW SW SE SE	82.42	1178.56	37.63521	97.30295	RIM 1283.22 TOC 1282.91
MW-8 SE SE SW SE	277.64	1360.49	37.63575	97.30358	RIM 1283.29 TOC 1282.85
MW-9 SW SW SE SE	309.21	1231.07	37.63583	97.30312	RIM 1282.80 TOC 1282.35

