

WATER WELL RECORD

Form WWC-5

Division of Water Resources App. No.


Well ID

MW4

Original Record Correction Change in Well Ust

1 LOCATION OF WATER WELL: County Sedgwick Fraction SW 1/4 SW 1/4 SE 1/4 SE 1/4 Section Number 3 Township Number T 28 S Range Number R 1 E W

2 WELL OWNER: Last Name: Wayman First: L. Wayne Street or Rural Address where well is located (if unknown, distance and direction from nearest town or intersection): 3150 Southeast Blvd., Wichita KS

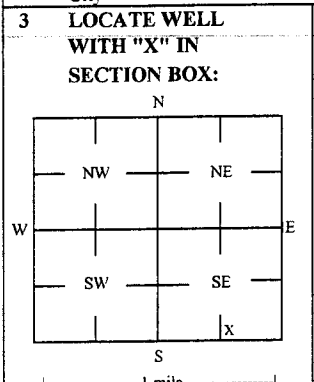

3 LOCATE WELL WITH "X" IN SECTION BOX: 4 DEPTH OF COMPLETED WELL: 29.9 ft Depth(s) Groundwater Encountered: 1) 29.9 ft 2) 3) 4) Dry Well WELL'S STATIC WATER LEVEL: 20.6 ft

5 Latitude: 37.63566 (decimal degrees) Longitude: 97.30335 (decimal degrees) Horizontal Datum: X WGS 84 Source for Latitude/Longitude: X Land Survey

7 WELL WATER TO BE USED AS: 1 Domestic: Household, Lawn & Garden, Livestock, Irrigation, Feedlot, Industrial 5 Public Water Supply: well ID 6 Dewatering: how many wells? 7 Aquifer Recharge: well ID 8 Monitoring: well ID MW4 9 Environmental Remediation: well ID 10 Oil Field Water Supply: lease 11 Test Hole: well ID 12 Geothermal: How many bores?

Was a chemical/bacteriological sample submitted to KDHE? Yes No If yes, date sample was submitted: Water well disinfected? Yes No

8 TYPE OF CASING USED: Steel PVC Other CASING JOINTS: Glued Clamped Welded Threaded Casing diameter 2 in. to 14.9 ft, Diameter in. to ft, Diameter in. to ft, Casing height above land surface -0.42 in. Weight lbs./ft. Well thickness or gauge No TYPE OF SCREEN OR PERFORATION MATERIAL: Steel Stainless Steel Fiberglass PVC Other (Specify) SCREEN OR PERFORATION OPENINGS ARE: Continuous Slot Mill Slot Gauze Wrapped Torch Cut Drilled Holes Other (Specify) Louvered Shutter Key Punched Wire Wrapped Saw Cut None (Open Hole) SCREEN-PERFORATED INTERVALS: From 14.9 ft to 29.9 ft, From ft. to ft, From ft. to ft, GRAVEL PACK INTERVALS: From 13 ft to 30 ft, From ft. to ft, From ft. to ft,

9 GROUT MATERIAL: Neat cement Cement grout Bentonite Other Concrete: 0-1' Grout intervals: From 1 ft. to 30 ft, From ft. to ft, From ft. to ft,

Nearest source of possible contamination: Septic Tank Lateral Lines Pit Privy Livestock Pens Insecticide Storage Sewer Lines Cess Pool Sewage Lagoon Fuel Storage Abandoned Water Well Watertight Sewer Lines Seepage Pit Feedyard Fertilizer Storage Oil Well / Gas Well Other (Specify) Direction from well? SE Distance from well? ~90 ft

Table with 6 columns: FROM, TO, LITHOLOGIC LOG, FROM, TO, LITHO. LOG (cont.) or PLUGGING INTERVALS. Rows include: 0-0.5 Asphalt and concrete, 0.5-1.5 Sand fill, 1.5-5 Dark gray silty clay, 5-10 Brown to gray silty clay, 10-12 Dark brown silty clay, 12-15 Very fine brown to gray sand, 15-25 Fine to medium brown to gray sand, 25-29 Medium brown to gray sand, 29-30 Dark gray silty clay. Notes: KDHE ID: L Wayne Wayman; U2-087-14692

11 CONTRACTOR'S OR LANDOWNER'S CERTIFICATION: This water well was constructed, reconstructed, or plugged under my jurisdiction and was completed on (mo-day-year) 9/29/15 and this record is true to the best of my knowledge and belief. Kansas Water Well Contractor's License No 757 This Water Well Record was completed on (mo-day-year) 1/6/16 under the business name of Larsen & Associates, Inc. Signature

TRITERRA LAND SERVICES

P.O. Box 546
Clearwater, Kansas 67026
Cell (316) 648-3617 Fax (620) 584-4371
E-mail: triterrals@yahoo.com

SURVEYING OF MONITORING WELLS
L. WAYNE WAYMAN
3150 SOUTHEAST BLVD.
WICHITA, KANSAS

The above site is located in Section 3, Township 28 South, Range 1 East of the Sixth Principal Meridian, Sedgwick County, Kansas. The Southeast corner of Section 3 was assigned coordinates of 00.00 North and 00.00 West.

The vertical control was obtained from the City of Wichita, described as a chiseled square on top of the headwall of a culvert at the northwest corner of the new QuikTrip property south of the site and 31st Street. Elevation: 1283.71. A control point was established as a chiseled 'X' at the interior northwest corner of the fenced enclosure on site.

The Latitude and Longitude were recorded from a GPS unit. The site is located on the 7.5' quad map titled "Wichita East".

ID	NORTH	WEST	LATITUDE	LONGITUDE	ELEVATION
SE CORNER 3-T28S-R1E	00.00	00.00			
CP	138.20	1275.08	37.63537	97.30328	1283.46
MW-1 SW SW SE SE	150.33	1195.82	37.63539	97.30299	RIM 1283.18 TOC 1282.73
MW-2 SW SW SE SE	185.93	1111.73	37.63551	97.30271	RIM 1283.17 TOC 1282.67
MW-3 SW SW SE SE	140.91	1260.49	37.63538	97.30325	RIM 1283.45 TOC 1283.17
MW-4 SW SW SE SE	243.09	1299.47	37.63566	97.30335	RIM 1283.32 TOC 1282.90
MW-5 SW SW SE SE	124.52	1113.22	37.63533	97.30273	RIM 1283.42 TOC 1282.82
MW-6 SW SW SE SE	87.70	1224.75	37.63523	97.30312	RIM 1283.29 TOC 1283.03
MW-7 SW SW SE SE	82.42	1178.56	37.63521	97.30295	RIM 1283.22 TOC 1282.91
MW-8 SE SE SW SE	277.64	1360.49	37.63575	97.30358	RIM 1283.29 TOC 1282.85
MW-9 SW SW SE SE	309.21	1231.07	37.63583	97.30312	RIM 1282.80 TOC 1282.35

