

WATER WELL RECORD

Form WWC-5

Division of Water Resources App. No.


Well ID

MW6

Original Record Correction Change in Well Ust

1 LOCATION OF WATER WELL: County Sedgwick Fraction SW 1/4 SW 1/4 SE 1/4 SE 1/4 Section Number 3 Township Number T 28 S Range Number R 1 E W

2 WELL OWNER: Last Name: Wayman First: L. Wayne Street or Rural Address where well is located (if unknown, distance and direction from nearest town or intersection): 3150 Southeast Blvd., Wichita KS

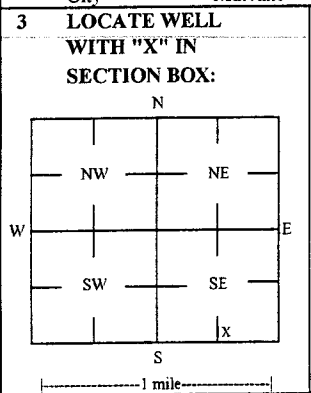

4 DEPTH OF COMPLETED WELL: 29.6 ft Depth(s) Groundwater Encountered: 1) 29.6 ft 2) 3) 4) Dry Well WELL'S STATIC WATER LEVEL: 20.7 ft

5 Latitude: 37.63523 (decimal degrees) Longitude: -97.30312 (decimal degrees) Horizontal Datum: X WGS 84 NAD 83 NAD 27

6 Elevation: 1283.03 ft Ground Level: X TOC Source: X Land Survey GPS Topographic Map

7 WELL WATER TO BE USED AS: 1 Domestic: Household Lawn & Garden Livestock Irrigation Feedlot Industrial 5 Public Water Supply: well ID 6 Dewatering: how many wells? 7 Aquifer Recharge: well ID 8 Monitoring: well ID MW6 9 Environmental Remediation: well ID Air Sparge Soil Vapor Extractor Recovery Injection 10 Oil Field Water Supply: lease 11 Test Hole: well ID Cased Uncased Geotechnical 12 Geothermal: How many bores? a) Closed Loop Horizontal Vertical b) Open Loop Surface Discharge Inj. of Water Other (specify):

Was a chemical/bacteriological sample submitted to KDHE? Yes No X No If yes, date sample was submitted: Water well disinfected? Yes No X No

8 TYPE OF CASING USED: Steel PVC Other CASING JOINTS: Glued Clamped Welded X Threaded Casing diameter 2 in. to 14.6 ft, Diameter in. to ft, Diameter in. to ft, Casing height above land surface -0.26 in. Weight lbs./ft. Well thickness or gauge No TYPE OF SCREEN OR PERFORATION MATERIAL: Steel Stainless Steel Fiberglass PVC Other (Specify) Brass Galvanized Steel Concrete tile None used (open hole) SCREEN OR PERFORATION OPENINGS ARE: Continuous Slot X Mill Slot Gauze Wrapped Torch Cut Drilled Holes Other (Specify) Louvered Shutter Key Punched Wire Wrapped Saw Cut None (Open Hole) SCREEN-PERFORATED INTERVALS: From 14.6 ft. to 29.6 ft. GRAVEL PACK INTERVALS: From 13 ft. to 30 ft.

9 GROUT MATERIAL: Neat cement Cement grout X Bentonite X Other Concrete: 0-1' Grout intervals: From 1 ft. to 30 ft. From ft. to ft. From ft. to ft.

Nearest source of possible contamination: Septic Tank Lateral Lines Pit Privy Livestock Pens Insecticide Storage Sewer Lines Cess Pool Sewage Lagoon X Fuel Storage Abandoned Water Well Watertight Sewer Lines Seepage Pit Feedyard Fertilizer Storage Oil Well / Gas Well Other (Specify) Direction from well? N Distance from well? ~75 ft

Table with 6 columns: FROM, TO, LITHOLOGIC LOG, FROM, TO, LITHO. LOG (cont.) or PLUGGING INTERVALS. Rows include: 0-0.9 Concrete and gravel, 0.9-12 Brown to dark gray silty clay, 12-14.5 Tan to gray silty clay, 14.5-15 Fine tan sand, 15-20 Fine to medium tan to gray sand, 20-30 Medium tan and gray sand.

Notes: KDHE ID: L Wayne Wayman; U2-087-14692

11 CONTRACTOR'S OR LANDOWNER'S CERTIFICATION: This water well was X constructed, reconstructed, or plugged under my jurisdiction and was completed on (mo-day-year) 9/30/15 and this record is true to the best of my knowledge and belief. Kansas Water Well Contractor's License No 757 This Water Well Record was completed on (mo-day-year) 1/6/16 under the business name of Larsen & Associates, Inc. Signature

TRITERRA

LAND SERVICES

P.O. Box 546
Clearwater, Kansas 67026
Cell (316) 648-3617 Fax (620) 584-4371
E-mail: triterrals@yahoo.com

SURVEYING OF MONITORING WELLS
L. WAYNE WAYMAN
3150 SOUTHEAST BLVD.
WICHITA, KANSAS

The above site is located in Section 3, Township 28 South, Range 1 East of the Sixth Principal Meridian, Sedgwick County, Kansas. The Southeast corner of Section 3 was assigned coordinates of 00.00 North and 00.00 West.

The vertical control was obtained from the City of Wichita, described as a chiseled square on top of the headwall of a culvert at the northwest corner of the new QuikTrip property south of the site and 31st Street. Elevation: 1283.71. A control point was established as a chiseled 'X' at the interior northwest corner of the fenced enclosure on site.

The Latitude and Longitude were recorded from a GPS unit. The site is located on the 7.5' quad map titled "Wichita East".

ID	NORTH	WEST	LATITUDE	LONGITUDE	ELEVATION
SE CORNER 3-T28S-R1E	00.00	00.00			
CP	138.20	1275.08	37.63537	97.30328	1283.46
MW-1 SW SW SE SE	150.33	1195.82	37.63539	97.30299	RIM 1283.18 TOC 1282.73
MW-2 SW SW SE SE	185.93	1111.73	37.63551	97.30271	RIM 1283.17 TOC 1282.67
MW-3 SW SW SE SE	140.91	1260.49	37.63538	97.30325	RIM 1283.45 TOC 1283.17
MW-4 SW SW SE SE	243.09	1299.47	37.63566	97.30335	RIM 1283.32 TOC 1282.90
MW-5 SW SW SE SE	124.52	1113.22	37.63533	97.30273	RIM 1283.42 TOC 1282.82
MW-6 SW SW SE SE	87.70	1224.75	37.63523	97.30312	RIM 1283.29 TOC 1283.03
MW-7 SW SW SE SE	82.42	1178.56	37.63521	97.30295	RIM 1283.22 TOC 1282.91
MW-8 SE SE SW SE	277.64	1360.49	37.63575	97.30358	RIM 1283.29 TOC 1282.85
MW-9 SW SW SE SE	309.21	1231.07	37.63583	97.30312	RIM 1282.80 TOC 1282.35

