


1 LOCATION OF WATER WELL: Fraction NE 1/4 SE 1/4 SE 1/4 Section Number 18 Township Number T 28 S Range Number R 1 E/W
County: Sedgwick

Distance and direction from nearest town or city street address of well if located within city? 4255 South Seneca

2 WATER WELL OWNER: Coastal Mgmt, Inc
RR#, St. Address, Box #: 4255 S. Seneca
City, State, ZIP Code: Wichita, KS
Board of Agriculture, Division of Water Resources
Application Number: MW7

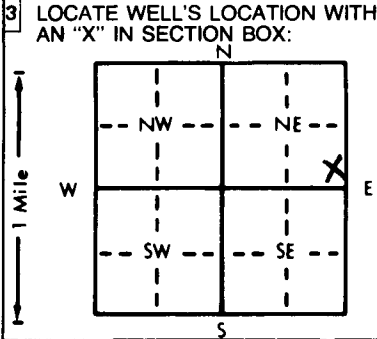

4 DEPTH OF COMPLETED WELL: 15' ft. ELEVATION: Not Surveyed yet
Depth(s) Groundwater Encountered 1. 8.53 ft. 2. 8.97 ft. 3. _____ ft.
WELL'S STATIC WATER LEVEL NA ft. below land surface measured on mo/day/yr _____
Pump test data: Well water was _____ ft. after _____ hours pumping _____ gpm
Est. Yield _____ gpm; Well water was _____ ft. after _____ hours pumping _____ gpm
Bore Hole Diameter 8 in. to 15 ft., and _____ in. to _____ ft.
WELL WATER TO BE USED AS: 5 Public water supply 8 Air conditioning 11 Injection well
1 Domestic 3 Feedlot 6 Oil field water supply 9 Dewatering 12 Other (Specify below)
2 Irrigation 4 Industrial 7 Lawn and garden only Monitoring well
Was a chemical/bacteriological sample submitted to Department? Yes _____ No ; If yes, mo/day/yr sample was submitted
Water Well Disinfected? Yes _____ No

5 TYPE OF BLANK CASING USED: 5 Wrought iron 8 Concrete tile CASING JOINTS: Glued _____ Clamped _____
1 Steel 3 RMP (SR) 6 Asbestos-Cement 9 Other (specify below) Welded _____
 PVC 4 ABS 7 Fiberglass _____ Threaded
Blank casing diameter 2 in. to 3 ft., Dia _____ in. to _____ ft., Dia _____ in. to _____ ft.
Casing height above land surface Flush in., weight _____ lbs./ft. Wall thickness or gauge No. _____
TYPE OF SCREEN OR PERFORATION MATERIAL: PVC 10 Asbestos-cement
1 Steel 3 Stainless steel 5 Fiberglass 8 RMP (SR) 11 Other (specify) _____
2 Brass 4 Galvanized steel 6 Concrete tile 9 ABS 12 None used (open hole)
SCREEN OR PERFORATION OPENINGS ARE: 5 Gauzed wrapped 8 Saw cut 11 None (open hole)
1 Continuous slot Mill slot 6 Wire wrapped 9 Drilled holes
2 Louvered shutter 4 Key punched 7 Torch cut 10 Other (specify) _____
SCREEN-PERFORATED INTERVALS: From 15' ft. to 5+3 ft., From _____ ft. to _____ ft.
From _____ ft. to _____ ft., From _____ ft. to _____ ft.
GRAVEL PACK INTERVALS: From 15' ft. to 4+2 ft., From _____ ft. to _____ ft.
From _____ ft. to _____ ft., From _____ ft. to _____ ft.

6 GROUT MATERIAL: 1 Neat cement 2 Cement grout Bentonite 4 Other _____
Grout Intervals: From 4' ft. to _____ ft., From _____ ft. to _____ ft., From _____ ft. to _____ ft.
What is the nearest source of possible contamination:
1 Septic tank 4 Lateral lines 7 Pit privy Fuel storage 14 Abandoned water well
2 Sewer lines 5 Cess pool 8 Sewage lagoon 12 Fertilizer storage 15 Oil well/Gas well
3 Watertight sewer lines 6 Seepage pit 9 Feedyard 13 Insecticide storage 16 Other (specify below)
Direction from well? _____ How many feet? _____

FROM	TO	LITHOLOGIC LOG	FROM	TO	PLUGGING INTERVALS
6"	2'	Dark Brown silty clay, lean			
2	10'	Lt. Brown f-med gr sand			
10	11'	Black-Gray, poorly sorted coarse sand, odor			
11	15'	Brown med-coarse sand, wet, odor			

7 CONTRACTOR'S OR LANDOWNER'S CERTIFICATION: This water well was constructed, reconstructed, or plugged under my jurisdiction and was completed on (mo/day/year) 4-30-98 and this record is true to the best of my knowledge and belief. Kansas Water Well Contractor's License No. 634 This Water Well Record was completed on (mo/day/yr) 6-8-98 under the business name of Shirley E.W. Tostler, LLC by (signature) [Signature]

OFFICE USE ONLY
T
R
EW
SEC.
1/4
1/4
1/4