

WATER WELL PLUGGING RECORD Form WWC-5P
KSA 82a-1212 ID NO.

1 LOCATION OF WATER WELL: County: <u>Sedgwick</u>	Fraction: <u>NW 1/4 NE 1/4 NW 1/4 SW 1/4</u>	Section Number: <u>17</u>	Township Number: <u>T 28 S</u>	Range Number: <u>1</u> ☒ E ☐ W
---	--	---------------------------	--------------------------------	---

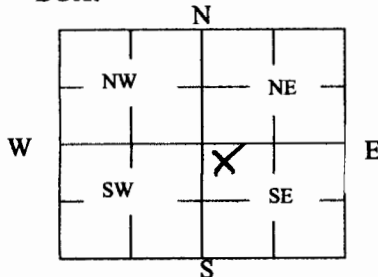
Street/Rural Address of Well Location; if unknown, distance & direction from nearest town or intersection: If at owner's address, check here ☒

Global Positioning Systems (GPS) information:

Latitude: 37.6146433 (in decimal degrees)
 Longitude: -97.34922194448 (in decimal degrees)
 Elevation: _____
 Horizontal Datum: ☐ WGS84, ☐ NAD83, ☐ NAD27
 Collection Method: _____

2 WATER WELL OWNER: Chad & Amy McCoskey
 RR#, St. Address, Box #: 4428 S. Osage
 City, State ZIP Code: Wichita, KS, 67217

☐ GPS unit (Make/Model: Cell Phone)
☐ Digital Map/Photo, ☐ Topographic Map, ☐ Land Survey
 Est. Accuracy: ☐ < 3 m, ☐ 3-5 m, ☐ 5-15 m, ☐ > 15 m

3 MARK WELL'S LOCATION WITH AN "X" IN SECTION BOX:

4 DEPTH OF WELL 35 ft.

 WELL'S STATIC WATER LEVEL 24 ft

WELL WAS USED AS:

- | | | |
|-------------------------------------|--|---|
| ☐ Domestic | ☐ Public Water Supply | ☐ Dewatering |
| ☐ Irrigation | ☐ Oil Field Water Supply | ☐ Monitoring |
| ☐ Feedlot | ☒ Domestic (Lawn & Garden) | ☐ Injection Well |
| ☐ Industrial | ☐ Air Conditioning | ☐ Other _____ |

 Was a chemical/bacteriological sample submitted to Department? Yes ☐ No ☐
5 TYPE OF BLANK CASING USED:

- ☐ Steel ☐ RMP (SR) ☐ Wrought ☐ Fiberglass ☐ Other (Specify below)
☒ PVC ☐ ABS ☐ Asbestos-Cement ☐ Concrete Tile

Blank casing diameter 5 in. Was casing pulled? Yes ☐ No ☒ If yes, how much _____
 Casing height above of below land surface 36 in.

6 GROUT PLUG MATERIAL:

- ☐ Neat cement ☐ Cement grout ☒ Bentonite ☐ Other _____

Grout Plug Intervals: From 3 ft. to 5 ft., From 22 ft. to 24 ft., From _____ ft. to _____ ft.

What is the nearest source of possible contamination:

- | | | | |
|---|---|---|--|
| ☐ Septic tank | ☐ Seepage pit | ☐ Fuel storage | ☐ Other (specify below) |
| ☒ Sewer lines | ☐ Pit privy | ☐ Fertilizer storage | |
| ☐ Watertight sewer lines | ☐ Sewage lagoon | ☐ Insecticide storage | |
| ☐ Lateral lines | ☐ Feedyard | ☐ Abandoned water well | |
| ☐ Cess pool | ☐ Livestock pens | ☐ Oil well/Gas well | |

Direction from well? South
 How many feet? 15 feet

FROM	TO	PLUGGING MATERIALS	FROM	TO	PLUGGING MATERIALS
			0	3	Dirt
			3	5	Bentonite
			5	22	Sand
			22	24	Bentonite
			24	35	Sand

7 CONTRACTOR'S OR LANDOWNER'S CERTIFICATION: This water well was plugged under my jurisdiction and was completed on (mo/day/year) 5/22/2016 and this record is true to the best of my knowledge and belief. Kansas Water Well Contractor's License No. _____. This Water Well Record was completed on (mo/day/year) 5/22/2016 under the business name of _____ by (signature) Chad McCoskey "home owner"

Send one white copy to Kansas Department of Health & Environment, Geology Section, 1000 SW Jackson Street, Ste. 420, Topeka, KS 66612-1367. Send one copy to WATER WELL OWNER and retain one for your records.
 Visit us at <http://www.kdheks.gov/waterwell/index.html> Telephone 785-296-5524.