WATER WELL RECORD Form WWC-5 KSA 82a-1212

1 LOCATION OF ~~WATER~~ VAPOR WELLS

County:	Fraction	Section Number	Township Number	Range Number
SEDWICK	SE ¼ NE ¼ NE ¼	29	T 28 S	R 1 (E) W

~~Distance and direction from nearest town~~ or city street address of well if located within city?
5858 S. BROADWAY WICHITA, KS

2 ~~WATER~~ WELL OWNER: (TANK OWNER) MART, Inc. - CHARLES TESTERMAN - 316/522-6551
RR#, St. Address, Box # : 5858 S. BROADWAY
City, State, ZIP Code : WICHITA, KS 67216

Board of Agriculture, Division of Water Resources
Application Number:

3 LOCATE WELL'S LOCATION WITH AN "X" IN SECTION BOX:

SEE MAP

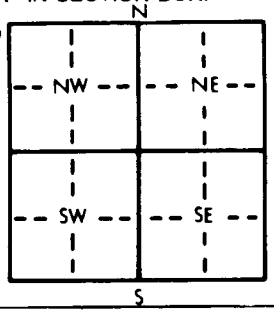

4 DEPTH OF COMPLETED WELL: SEE LOG ft. ELEVATION: —
Depth(s) Groundwater Encountered 1. NONE ft. 2. — ft. 3. — ft.
WELL'S STATIC WATER LEVEL — ft. below land surface measured on mo/day/yr
Pump test data: Well water was — ft. after — hours pumping — gpm
Est. Yield gpm: Well water was — ft. after — hours pumping — gpm
Bore Hole Diameter 4 in. to 3 ft., and 2.25 in. to SEE WELL LOG ft.
WELL WATER TO BE USED AS: 1 Domestic 2 Irrigation 3 Feedlot 4 Industrial 5 Public water supply 6 Oil field water supply 7 Lawn and garden only 8 Air conditioning 9 Dewatering 10 Monitoring well 11 Injection well (12) Other (Specify below) VAPOR WELLS
Was a chemical/bacteriological sample submitted to Department? Yes ..... No X ; If yes, mo/day/yr sample was submitted
Water Well Disinfected? Yes — No —

5 TYPE OF BLANK CASING USED: 1 Steel (2) PVC 3 RMP (SR) 4 ABS 5 Wrought iron 6 Asbestos-Cement 7 Fiberglass 8 Concrete tile 9 Other (specify below)
CASING JOINTS: Glued X Clamped Welded Threaded
Blank casing diameter 1.5 in. to TOTAL DEPTH SEE LOG ft., Dia — in. to — ft., Dia — in. to — ft.
Casing height above land surface 0 in., weight 0 lbs./ft. Wall thickness or gauge No. SCHEDULE 40
TYPE OF SCREEN OR PERFORATION MATERIAL: 1 Steel 2 Brass 3 Stainless steel 4 Galvanized steel 5 Fiberglass 6 Concrete tile (7) PVC 8 RMP (SR) 9 ABS 10 Asbestos-cement 11 Other (specify) 12 None used (open hole)
SCREEN OR PERFORATION OPENINGS ARE: 1 Continuous slot 2 Louvered shutter 3 Mill slot 4 Key punched 5 Gauzed wrapped 6 Wire wrapped 7 Torch cut (8) Saw cut 9 Drilled holes 10 Other (specify) .010" slot 11 None (open hole)
SCREEN-PERFORATED INTERVALS: From SEE WELL LOG ft. to SEE LOG ft., From — ft. to — ft.
From — ft. to — ft., From — ft. to — ft.
GRAVEL PACK INTERVALS: From N/A ft. to — ft., From — ft. to — ft.
From — ft. to — ft., From — ft. to — ft.

6 GROUT MATERIAL: (1) Neat cement 2 Cement grout 3 Bentonite 4 Other
Grout Intervals: From 0 ft. to 3 ft., From — ft. to — ft., From — ft. to — ft.
What is the nearest source of possible contamination: SEE MAP
1 Septic tank 2 Sewer lines 3 Watertight sewer lines 4 Lateral lines 5 Cess pool 6 Seepage pit 7 Pit privy 8 Sewage lagoon 9 Feedyard 10 Livestock pens (11) Fuel storage 12 Fertilizer storage 13 Insecticide storage 14 Abandoned water well 15 Oil well/Gas well 16 Other (specify below)
Direction from well? SEE MAP How many feet? < ONE FOOT - ALWAYS

FROM	TO	LITHOLOGIC LOG	FROM	TO	PLUGGING INTERVALS
Surface	SEE	WELL LOG			N/A

7 CONTRACTOR'S OR LANDOWNER'S CERTIFICATION: This ~~water~~ VAPOR well ~~was~~ WERE (1) constructed, (2) reconstructed, or (3) plugged under my jurisdiction and was completed on (mo/day/year) 09/06/91 and this record is true to the best of my knowledge and belief. Kansas Water Well Contractor's License No. 544 This Water Well Record was completed on (mo/day/yr) 09/11/91
under the business name of VAPOR WELL SYSTEMS by (signature) Steve Osborn

INSTRUCTIONS: Use typewriter or ball point pen. *PLEASE PRESS FIRMLY* and *PRINT* clearly. Please fill in blanks, underline or circle the correct answers. Send top three copies to Kansas Department of Health and Environment, Bureau of Water, Topeka, Kansas 66620-0001. Telephone: 913-296-5545. Send one to WATER WELL OWNER and retain one for your records.

OFFICE USE ONLY T R E/W SEC. ¼ ¼ ¼

SEP 3 REC'D by VWS