


1 LOCATION OF WATER WELL: County: <u>SEDGWICK</u>	Fraction SW $\frac{1}{4}$ NW $\frac{1}{4}$ SW $\frac{1}{4}$	Section Number <u>29</u>	Township Number T <u>28</u> S	Range Number R <u>1</u> E <u>EW</u>
--	--	-----------------------------	----------------------------------	--

Distance and direction from nearest town or city street address of well if located within city?

6162 S. Seneca, Wichita, Ks.
2 WATER WELL OWNER: Diane Jefferson
RR#, St. Address, Box # : 6162 S. Seneca Board of Agriculture, Division of Water Resources
City, State, ZIP Code : Wichita, Ks. Application Number:

3 LOCATE WELL'S LOCATION WITH AN "X" IN SECTION BOX:

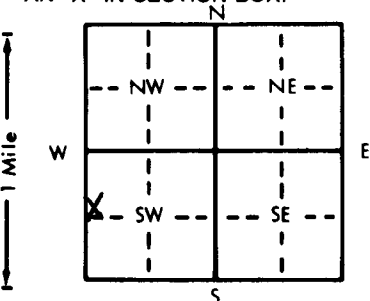

4 DEPTH OF COMPLETED WELL: 43 ft. ELEVATION: 17 ft. below land surface measured on mo/day/yr 7/3/81


WELL WATER TO BE USED AS: 5 Public water supply 8 Air conditioning 11 Injection well

1 Domestic 3 Feedlot 6 Oil field water supply 9 Dewatering 12 Other (Specify below)

2 Irrigation 4 Industrial 7 Lawn and garden only 10 Observation well

Was a chemical/bacteriological sample submitted to Department? Yes No X; If yes, mo/day/yr sample was submittedWater Well Disinfected? Yes X No

5 TYPE OF BLANK CASING USED: 5 Wrought iron 8 Concrete tile CASING JOINTS: Glued X Clamped Welded

1 Steel 3 RMP (SR) 6 Asbestos-Cement 9 Other (specify below) Threaded

2 PVC 4 ABS 7 Fiberglass 10 Asbestos-cement

Blank casing diameter 5 in. to 28 ft. Dia. in. to 28 ft. Dia. in. to 28 ft.Casing height above land surface 12 in., weight 1.59 lbs./ft. Wall thickness or gauge No. 203

TYPE OF SCREEN OR PERFORATION MATERIAL: 7 PVC 10 Asbestos-cement

1 Steel 3 Stainless steel 5 Fiberglass 8 RMP (SR) 11 Other (specify)

2 Brass 4 Galvanized steel 6 Concrete tile 9 ABS 12 None used (open hole)

SCREEN OR PERFORATION OPENINGS ARE: 5 Gauzed wrapped 8 Saw cut .06 11 None (open hole)

1 Continuous slot 3 Mill slot 6 Wire wrapped 9 Drilled holes

2 Louvered shutter 4 Key punched 7 Torch cut 10 Other (specify)

SCREEN-PERFORATED INTERVALS: From 28 ft. to 43 ft. From 28 ft. to 43 ft.GRAVEL PACK INTERVALS: From 14 ft. to 43 ft. From 14 ft. to 43 ft.

6 GROUT MATERIAL: 1 Neat cement 2 Cement grout 3 Bentonite 4 Other

Grout intervals: From 40" ft. to 14 ft. From 40" ft. to 14 ft.

What is the nearest source of possible contamination: 10 Livestock pens 14 Abandoned water well

1 Septic tank 4 Lateral lines 7 Pit privy 11 Fuel storage 15 Oil well/Gas well

2 Sewer lines 5 Cess pool 8 Sewage lagoon 12 Fertilizer storage 16 Other (specify below)

3 Watertight sewer lines 6 Seepage pit 9 Feedyard 13 Insecticide storage

Direction from well? Northeast How many feet? 68

FROM TO LITHOLOGIC LOG FROM TO LITHOLOGIC LOG

0 3 Topsoil

3 9 Clay

9 27 Fine Sand

27 29 Clay

29 43 Medium Sand

CONTRACTOR'S OR LANDOWNER'S CERTIFICATION: This water well was (1) constructed, (2) reconstructed, or (3) plugged under my jurisdiction and was

completed on (mo/day/year) 7/3/81 and this record is true to the best of my knowledge and belief. KansasWater Well Contractor's License No. 236 This Water Well Record was completed on (mo/day/yr) 8-12-81under the business name of Harp Well & Pump Serv., Inc. by (signature) Mr. Arnold

INSTRUCTIONS: Use typewriter or ball point pen, PLEASE PRESS FIRMLY and PRINT clearly. Please fill in blanks, underline or circle the correct answers. Send top

three copies to Kansas Department of Health and Environment, Division of Environment, Environmental Geology Section, Topeka, KS 66620. Send one to WATER WELL

OWNER and retain one for your records.