WATER WELL PLUGGING RECORD Form WWC-5P KSA 82a-1212 ID NO.

1 LOCATION OF WATER WELL: County: Sedgwick

Fraction: se ¼ nw ¼ nw ¼ ne ¼ | Section Number: 8 | Township Number: T 28 S | Range Number: 1 ☑ E ☐ W

Street/Rural Address of Well Location; if unknown, distance & direction from nearest town or intersection: If at owner's address, check here ☐ backyard - 3237 S Wichita St
Wichita KS 67217

Global Positioning Systems (GPS) information:
Latitude: 37 38 9.57 (in decimal degrees)
Longitude: 97 20 21.68 (in decimal degrees)
Elevation: 1296'
Horizontal Datum: ☐ WGS84, ☑ NAD83, ☐ NAD27
Collection Method:
☑ GPS unit (Make/Model: Cell Phone
☐ Digital Map/Photo, ☐ Topographic Map, ☐ Land Survey
Est. Accuracy: ☑ < 3 m, ☐ 3-5 m, ☐ 5-15 m, ☐ > 15 m

2 WATER WELL OWNER: Delores Downs
RR#, St. Address, Box #: 813 N Timberleaf Dr
City, State ZIP Code: Derby KS 67037

3 MARK WELL'S LOCATION WITH AN "X" IN SECTION BOX:

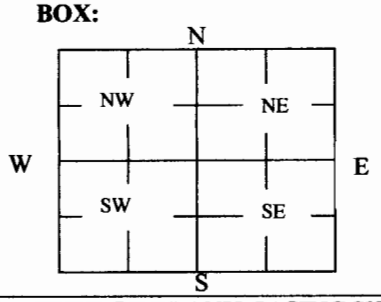

4 DEPTH OF WELL 22 ft.

WELL'S STATIC WATER LEVEL 19 ft

WELL WAS USED AS:

☐ Domestic ☐ Irrigation ☐ Feedlot ☐ Industrial
☐ Public Water Supply ☐ Oil Field Water Supply ☑ Domestic (Lawn & Garden) ☐ Air Conditioning
☐ Dewatering ☐ Monitoring ☐ Injection Well ☐ Other

Was a chemical/bacteriological sample submitted to Department? Yes ☐ No ☑

5 TYPE OF BLANK CASING USED:

☐ Steel ☑ PVC ☐ RMP (SR) ☐ ABS ☐ Wrought ☐ Asbestos-Cement ☐ Fiberglass ☐ Concrete Tile ☐ Other (Specify below)

Blank casing diameter 5 in. Was casing pulled? Yes ☑ No ☐ If yes, how much 2.5 ft
Casing height above or below land surface 30" below in.

6 GROUT PLUG MATERIAL: ☐ Neat cement ☐ Cement grout ☑ Bentonite ☐ Other

Grout Plug Intervals: From 20 ft. to 18 ft., From 4 ft. to 2 ft., From ____ ft. to ____ ft.

What is the nearest source of possible contamination:

☐ Septic tank ☐ Sewer lines ☐ Watertight sewer lines ☐ Lateral lines ☐ Cess pool
☐ Seepage pit ☐ Pit privy ☐ Sewage lagoon ☐ Feedyard ☐ Livestock pens
☐ Fuel storage ☐ Fertilizer storage ☐ Insecticide storage ☐ Abandoned water well ☐ Oil well/Gas well
☑ Other (specify below) Well was abandoned

Direction from well? ____
How many feet? ____

FROM	TO	PLUGGING MATERIALS	FROM	TO	PLUGGING MATERIALS
2	0	Topsoil			
4	2	Bentonite			
18	4	Subsoil			
20	18	Bentonite			
22	20	Sand			

7 CONTRACTOR'S OR LANDOWNER'S CERTIFICATION: This water well was plugged under my jurisdiction and was completed on (mo/day/year) 9/3/16 and this record is true to the best of my knowledge and belief. Kansas Water Well Contractor's License No. 628. This Water Well Record was completed on (mo/day/year) 9/3/16 under the business name of JMEnterprises by (signature) [signature]

Send one white copy to Kansas Department of Health & Environment, Geology Section, 1000 SW Jackson Street, Ste. 420, Topeka, KS 66612-1367. Send one copy to WATER WELL OWNER and retain one for your records.
Visit us at http://www.kdheks.gov/waterwell/index.html Telephone 785-296-5524.