


WATER WELL RECORD Form WWC-5 KSA 82a-1212

1 LOCATION OF WATER WELL: Sedgwick	FRACTION NW 1/4 SW 1/4 SE 1/4	SECTION NUMBER 6	TOWNSHIP NUMBER T 28 S	RANGE NUMBER R 1E E/W
--	---	----------------------------	----------------------------------	---------------------------------

Distance and direction from nearest town or city street address of well if located within city?
Northwest Corner of 31st So. and Glenn Wichita, Kansas

2 WATER WELL OWNER: WICHITA, CITY OF	Board of Agriculture, Division of Water Resource
RR#, ST. ADDRESS, BOX #: 455 N. Main	Application Number:
CITY, STATE: Wichita, Kansas	ZIP CODE:

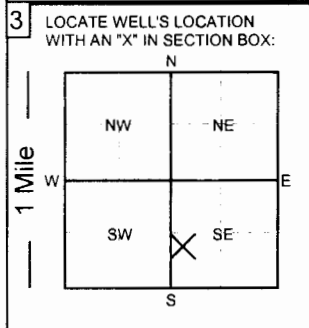

4 DEPTH OF COMPLETED WELL: 45 ft.	ELEVATION:
Depth of groundwater Encountered:	ft.
WELL'S STATIC WATER LEVEL 12 FT. BELOW LAND SURFACE MEASURED ON 11/3/17	
Pump test data: Well water was	ft. after
Est. Yield: gpm	hours of pumping @ gpm
Bore Hole Diameter 12 in.	to 45 ft. and in. to ft.
WELL WATER TO BE USED AS:	
1. Domestic	2. Irrigation
3. Feedlot	4. Industrial
5. Public water supply	6. Oil field water supply
7. Lawn and garden only	8. Air conditioning
9. Dewatering	10. Monitoring well
11. Injection well	12. Other (Specify below)
Was a chemical/bacteriological sample submitted to Department?	YES NO
Was Water Well Disinfected?	YES NO

5 TYPE OF CASING USED:	1. Steel	2. PVC	3. RPM (SR)	4. ABS	5. Wrought Iron	6. Asbestos-Cement	7. Fiberglass	8. Concrete tile	9. Other (Specify below)	CASING JOINTS:	1. Glued	2. Threaded
Blank casing diameter	8 in.	to	20 ft., Dia.	in.	to	ft., Dia.	in.	to	ft.	Welded	Clamped	
Casing height above land surface:	12 in.,	Weight:	5.52 lbs. / ft.	Wall thickness or gauge No.	.332							
TYPE OF SCREEN OR PERFORATION MATERIAL:	1. Steel	2. Brass	3. Stainless Steel	4. Galvanized	5. Fiberglass	6. Concrete Tile	7. PVC	8. RMP (SR)	9. ABS	10. Asbestos-Cement	11. Other (specify)	12. None used (open hole)
SCREEN OR PERFORATION OPENINGS ARE:	1. Continuous slot	2. Louvered shutter	3. Mill slot	4. Key punched	5. Gauzed wrapped	6. Wire wrapped	7. Torch cut	8. Saw cut	9. Drilled holes	10. Other (specify)	11. None (open hole)	
SCREEN - PERFORATION INTERVAL	From	20 ft.	to	37 ft.,	From	ft.	to	ft.				
GRAVEL PACK INTERVALS:	From	20 ft.	to	45 ft.,	From	ft.	to	ft.				

6 GROUT MATERIALS:	1. Neat cement	2. Cement Grout	3. Bentonite	Other	bentonite hole plug											
Grout Intervals:	From	0 ft.	to	20 ft.,	From	ft.	to	ft.								
What is the nearest source of possible contamination:	1. Septic tank	2. Sewer lines	3. Watertight sewer line	4. Lateral lines	5. Cess Pool	6. Seepage pit	7. Pit privy	8. Sewage lagoon	9. Feed yard	10. Livestock pens	11. Fuel storage	12. Fertilizer storage	13. Insecticide storage	14. Abandon water well	15. Oil well/Gas well	16. Other (specify below)
Direction from well?	North	How many feet?	10 ft. plus													

From	To	LITHOLOGIC LOG	From	To	LITHOLOGIC LOG
0	3	topsoil			
3	15	clay			
15	25	fine sand			
25	45	medium sand			

7 Contractor's or Landowner's Certification: This water well was 1. constructed 2. reconstructed or 3. plugged under my jurisdiction and was completed on (mo/day/year) 11/02/2017 and this record is true to the best of my knowledge and belief.
Kansas Water Well Contractor's License No. 236 under the business name of Harp Well and Pump Service This water well record was completed on (mo/day/year) 11/6/17 by (signature) Todd S. Harp