


**WATER WELL RECORD Form WWC-5 KSA 82a-1212**

1 LOCATION OF WATER WELL: <b>Sedgwick</b>	FRACTION <b>NW 1/4 SW 1/4 SW 1/4</b>	SECTION NUMBER <b>18</b>	TOWNSHIP NUMBER <b>T 28 S</b>	RANGE NUMBER <b>R 1E E/W</b>
--	---	-----------------------------	----------------------------------	---------------------------------

Distance and direction from nearest town or city street address of well if located within city?  
**2417 W. 45th St. South Wichita, Kansas 2 constructs on 1 permit**

2 WATER WELL OWNER: <b>GREIDER, Larry</b>	RR#,ST. ADDRESS,BOX #: <b>2417 W. 45th St. South</b>	CITY, STATE: <b>Wichita , Kansas</b>	ZIP CODE: <b>67217</b>	Application Number: <b>Board of Agriculture, Division of Water Resource</b>
--	---	---	---------------------------	--

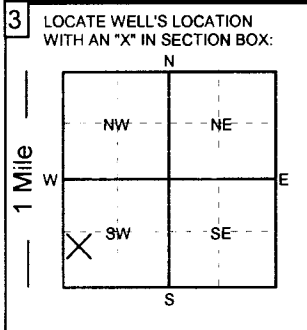

4 DEPTH OF COMPLETED WELL: <b>50</b> ft.	ELEVATION:
Depth of groundwater Encountered: _____ ft.	
WELL'S STATIC WATER LEVEL <b>10</b> FT. BELOW LAND SURFACE MEASURED ON <b>11/15/17</b>	
Pump test data: Well water was _____ ft. after _____ hours of pumping @ _____ gpm	
Est. Yield: _____ gpm Well water was _____ ft. after _____ hours of pumping @ _____ gpm	
Bore Hole Diameter <b>12</b> in. to <b>50</b> ft. and _____ in. to _____ ft.	
WELL WATER TO BE USED AS:	
1. Domestic    3. Feedlot    5. Public water supply <b>7. Lawn and garden only</b> 9. Dewatering    11. Injection well 2. Irrigation    4. Industrial    6. Oil field water supply    8. Air conditioning    10. Monitoring well    12. Other (Specify below)	
Was a chemical/bacteriological sample submitted to Department? <b>YES</b> <b>NO</b> ; If yes, what mo/day/yr was sample submitted _____	
Was Water Well Disinfected? <b>YES</b> <b>NO</b>	

5 TYPE OF CASING USED:	CASING JOINTS: <b>Glued</b> Threaded Welded Clamped
1. Steel    3. RPM (SR) <b>2. PVC</b> 4. ABS 5. Wrought Iron    7. Fiberglass    9. Other (Specify below) 6. Asbestos-Cement    8. Concrete tile    SDR-26	
Blank casing diameter <b>5</b> in. to <b>30</b> ft., Dia. _____ in. to _____ ft.	
Casing height above land surface: <b>12</b> in., Weight: <b>2.35</b> lbs. / ft. Wall thickness or gauge No. <b>.214</b>	
TYPE OF SCREEN OR PERFORATION MATERIAL:	
1. Steel    3. Stainless Steel    5. Fiberglass <b>7. PVC</b> 9. ABS    11. Other (specify) 2. Brass    4. Galvanized    6. Concrete Tile    8. RMP (SR)    10. Asbestos-Cement    12. None used (open hole)	
SCREEN OR PERFORATION OPENINGS ARE:	
1. Continuous slot    3. Mill slot    5. Gauzed wrapped    7. Torch cut    9. Drilled holes    11. None (open hole) 2. Louvered shutter    4. Key punched    6. Wire wrapped <b>8. Saw cut</b> 10. Other (specify)	
SCREEN - PERFORATION INTERVAL	From <b>30</b> ft. to <b>50</b> ft., From _____ ft. to _____ ft.
GRAVEL PACK INTERVALS:	From <b>24</b> ft. to <b>50</b> ft., From _____ ft. to _____ ft.

6 GROUT MATERIALS:	Other <b>benonite hole plug</b>
Grout Intervals: From <b>4</b> ft. to <b>24</b> ft., From _____ ft. to _____ ft.	
What is the nearest source of possible contamination:	
1. Septic tank    4. Lateral lines    7. Pit privy    10. Livestock pens    13. Insecticide storage    15. Oil well/Gas well 2. Sewer lines    5. Cess Pool    8. Sewage lagoon    11. Fuel storage    14. Abandon water well    16. Other (specify below) <b>3. Watertight sewer line</b> 6. Seepage pit    9. Feed yard    12. Fertilizer storage	
Direction from well? <b>Northwest</b>	How many feet? <b>100 ft. plus</b>

From	To	LITHOLOGIC LOG	From	To	LITHOLOGIC LOG
0	3	topsoil			
3	8	clay			
8	25	fine sand			
25	50	medium sand			

7 Contractor's or Landowner's Certification: This water well was 1. <b>constructed</b> 2. reconstructed or 3. plugged under my jurisdiction and was completed on (mo/day/year) <b>11/15/2017</b> and this record is true to the best of my knowledge and belief.	This water well record was completed on (mo/day/year) <b>11/17/17</b>
Kansas Water Well Contractor's License No. <b>236</b>	under the business name of <b>Harp Well and Pump Service</b>
	by (signature) <b>Todd S. Harp</b>