


WATER WELL RECORD Form WWC-5 KSA 82a-1212

1 LOCATION OF WATER WELL: Sedgwick FRACTION NW 1/4 SW 1/4 SE 1/4 SECTION NUMBER 21 TOWNSHIP NUMBER T 28 S RANGE NUMBER R 1E E/W

Distance and direction from nearest town or city street address of well if located within city? 5430 S. Victoria Wichita, Kansas

2 WATER WELL OWNER: LOVE, MIKE CONSTRUCTION RR#, ST. ADDRESS, BOX #: P.O. Box 7 CITY, STATE: Valley Center, Kansas ZIP CODE: 67147 Board of Agriculture, Division of Water Resource Application Number:

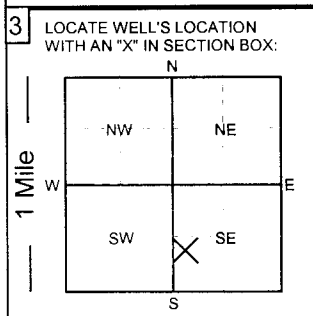

3 LOCATE WELL'S LOCATION WITH AN 'X' IN SECTION BOX: 4 DEPTH OF COMPLETED WELL: 36 ft. ELEVATION: Depth of groundwater Encountered: WELL'S STATIC WATER LEVEL 12 FT. BELOW LAND SURFACE MEASURED ON mo/day/yr: 6/12/18

5 TYPE OF CASING USED: 1. Steel 2. PVC 3. RPM (SR) 4. ABS 5. Wrought Iron 6. Asbestos-Cement 7. Fiberglass 8. Concrete tile 9. Other (Specify below) CASING JOINTS: Glued Threaded Welded Clamped

6 GROUT MATERIALS: 1. Neat cement 2. Cement Grout 3. Bentonite Other bentonite hole plug Grout Intervals: From 4 ft. to 24 ft. What is the nearest source of possible contamination: 3. Watertight sewer line

LITHOLOGIC LOG table with columns From, To, and description. Entries include topsoil (0-3 ft), fine sand (3-25 ft), and medium sand (25-36 ft).

7 Contractor's or Landowner's Certification: This water well was 1. constructed 2. reconstructed or 3. plugged under my jurisdiction and was completed on (mo/day/year) 6/12/18 and this record is true to the best of my knowledge and belief. Kansas Water Well Contractor's License No. 236 This water well record was completed on (mo/day/year) 6/14/18 under the business name of Harp Well and Pump Service by (signature) Todd S. Harp