




1 inch = 114 feet

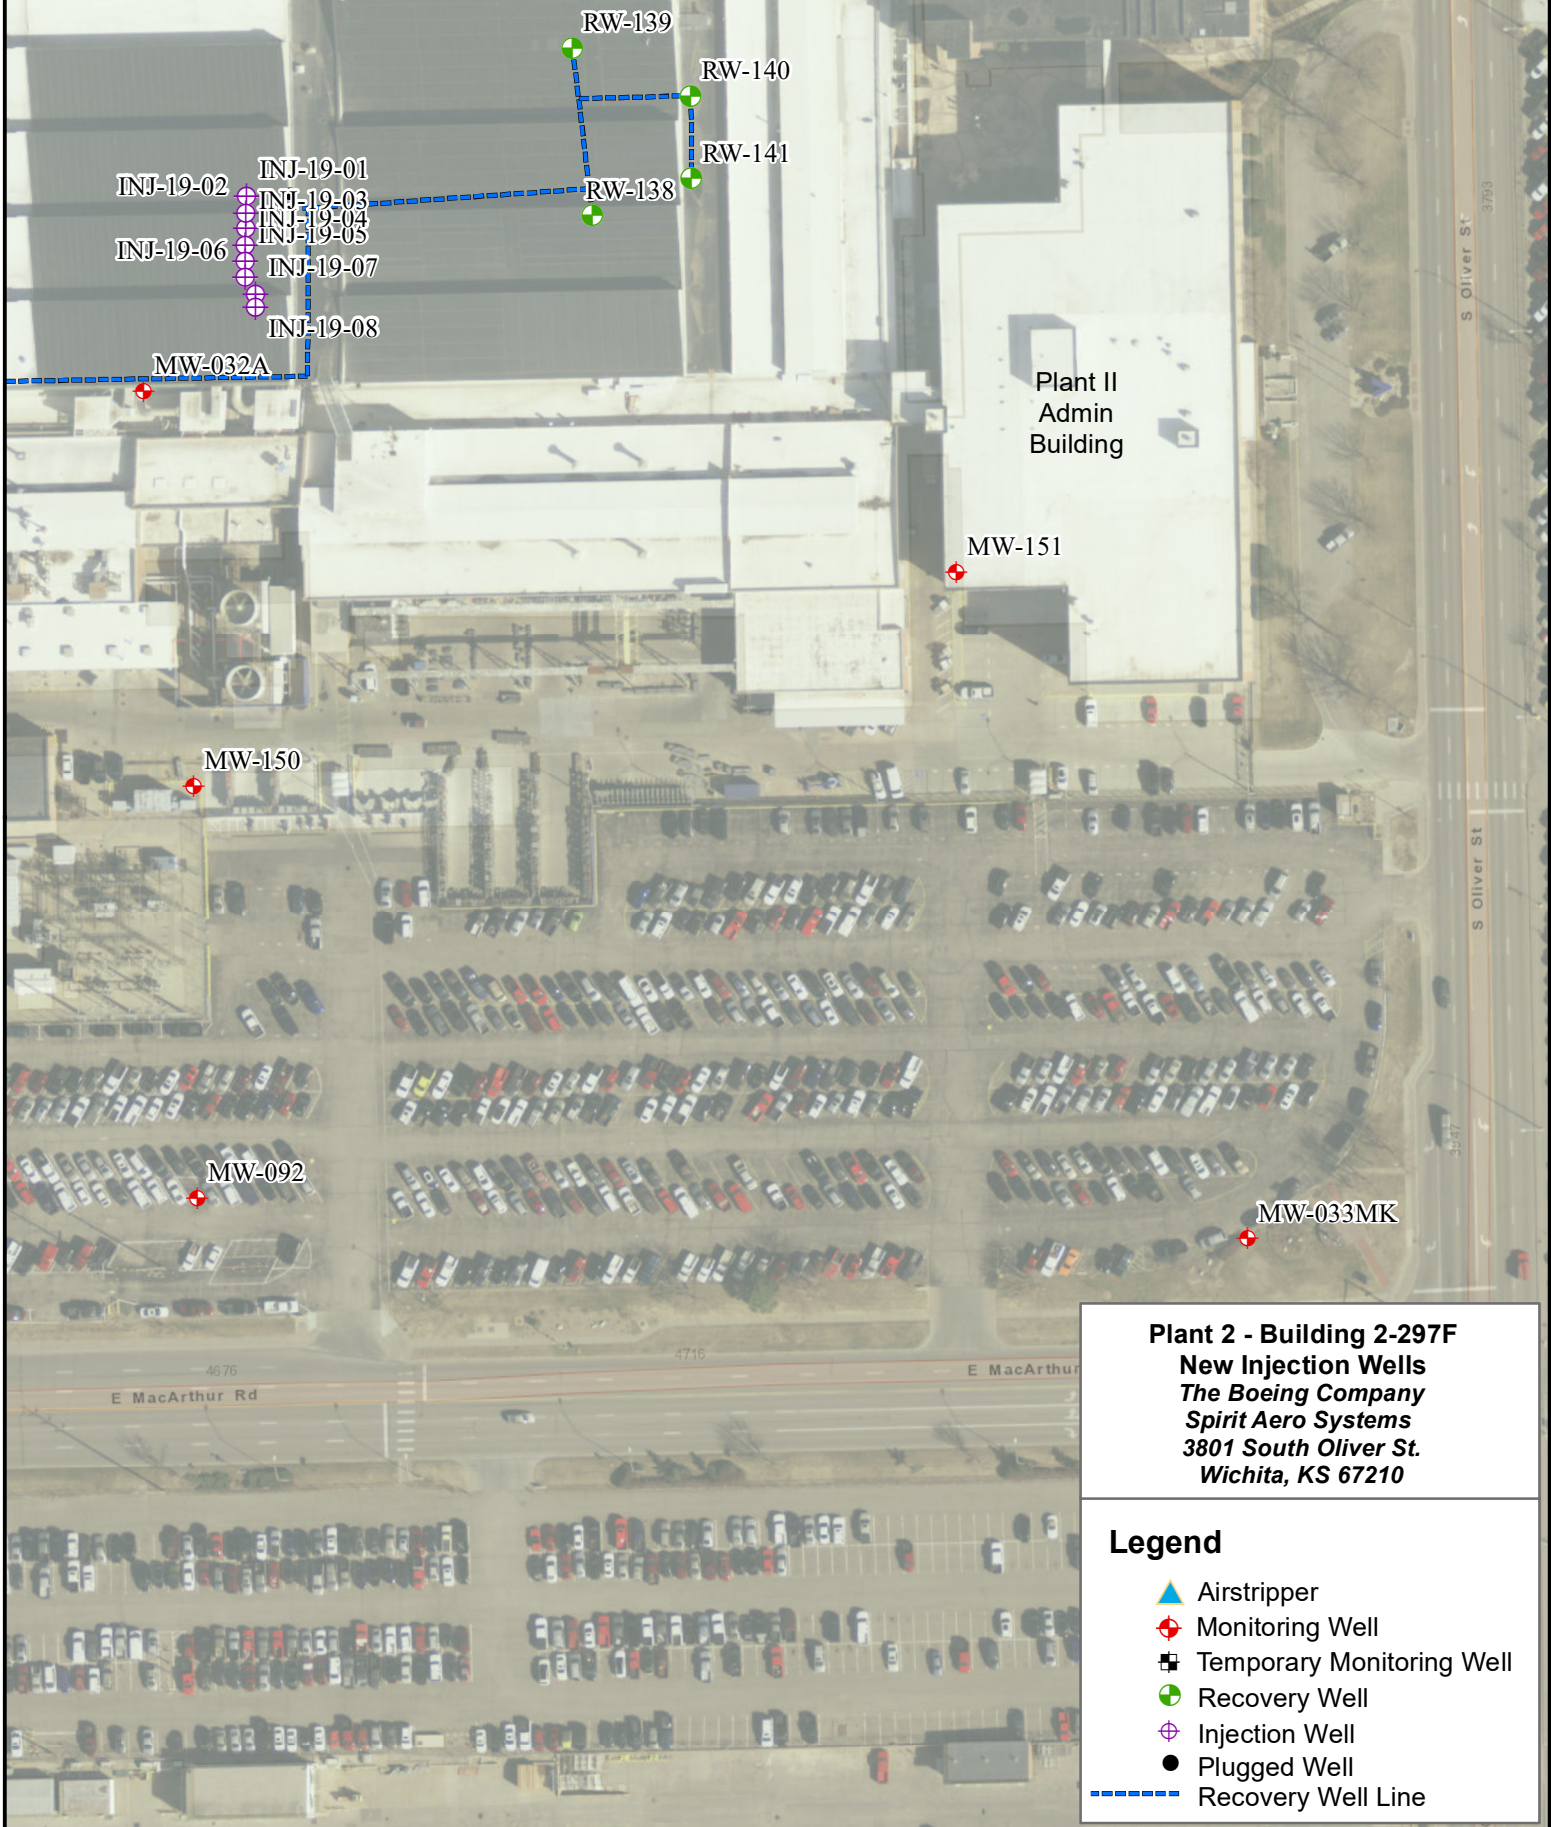

Plant 2 - Building 2-297F
New Injection Wells
The Boeing Company
Spirit Aero Systems
3801 South Oliver St.
Wichita, KS 67210

Legend

- Airstripper
- Monitoring Well
- Temporary Monitoring Well
- Recovery Well
- Injection Well
- Plugged Well
- Recovery Well Line