

WATER WELL RECORD Form WWC-5
☐ Original Record ☐ Correction ☐ Change in Well Use
Division of Water
Resources App. No.

Well ID

1 LOCATION OF WATER WELL:

County:

Fraction

 $\frac{1}{4}$ $\frac{1}{4}$ $\frac{1}{4}$ $\frac{1}{4}$

Section Number

Township Number

T

S

Range Number

R

☐ E☐ W**2 WELL OWNER:** Last Name:

First:

Business:

Address:

Address:


City:

State:

ZIP:

Street or Rural Address where well is located (if unknown, distance and direction from nearest town or intersection): If at owner's address, check here: ☐**3 LOCATE WELL WITH "X" IN SECTION BOX:**

N

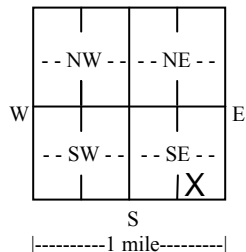**4 DEPTH OF COMPLETED WELL:** ft.

Depth(s) Groundwater Encountered: 1) ft.

2) ft. 3) ft., or 4) ☐ Dry Well

WELL'S STATIC WATER LEVEL: ft.

☐ below land surface, measured on (mo-day-yr).....☐ above land surface, measured on (mo-day-yr).....

Pump test data: Well water was ft.

after..... hours pumping gpm

Well water was ft.

after..... hours pumping gpm

Estimated Yield:gpm

Bore Hole Diameter: in. to ft. and

..... in. to ft.

5 Latitude:(decimal degrees)**Longitude:**(decimal degrees)Datum: ☐ WGS 84 ☐ NAD 83 ☐ NAD 27

Source for Latitude/Longitude:

☐ GPS (unit make/model:)(WAAS enabled? ☐ Yes ☐ No)☐ Land Survey ☐ Topographic Map☐ Online Mapper:**6 Elevation:**ft. ☐ Ground Level ☐ TOCSource: ☐ Land Survey ☐ GPS ☐ Topographic Map☐ Other**7 WELL WATER TO BE USED AS:**

1. Domestic:

☐ Household☐ Lawn & Garden☐ Livestock2. ☐ Irrigation3. ☐ Feedlot4. ☐ Industrial5. ☐ Public Water Supply: well ID6. ☐ Dewatering: how many wells?7. ☐ Aquifer Recharge: well ID8. ☐ Monitoring: well ID

9. Environmental Remediation: well ID

☐ Air Sparge ☐ Soil Vapor Extraction☐ Recovery ☐ Injection10. ☐ Oil Field Water Supply: lease

11. Test Hole: well ID

☐ Cased ☐ Uncased ☐ Geotechnical

12. Geothermal: how many bores?

a) Closed Loop ☐ Horizontal ☐ Verticalb) Open Loop ☐ Surface Discharge ☐ Inj. of Water13. ☐ Other (specify):**Was a chemical/bacteriological sample submitted to KDHE?** ☐ Yes ☐ No If yes, date sample was submitted:Water well disinfected? ☐ Yes ☐ No**8 TYPE OF CASING USED:** ☐ Steel ☐ PVC ☐ Other CASING JOINTS: ☐ Glued ☐ Clamped ☐ Welded ☐ Threaded

Casing diameter in. to ft., Diameter in. to ft., Diameter in. to ft.

Casing height above land surface in. Weight lbs./ft. Wall thickness or gauge No.

TYPE OF SCREEN OR PERFORATION MATERIAL:

☐ Steel ☐ Stainless Steel ☐ Fiberglass ☐ PVC☐ Other (Specify)☐ Brass ☐ Galvanized Steel ☐ Concrete tile ☐ None used (open hole)

SCREEN OR PERFORATION OPENINGS ARE:

☐ Continuous Slot ☐ Mill Slot ☐ Gauze Wrapped ☐ Torch Cut ☐ Drilled Holes ☐ Other (Specify)☐ Louvered Shutter ☐ Key Punched ☐ Wire Wrapped ☐ Saw Cut ☐ None (Open Hole)

SCREEN-PERFORATED INTERVALS: From ft. to ft., From ft. to ft., From ft. to ft.

GRAVEL PACK INTERVALS: From ft. to ft., From ft. to ft., From ft. to ft.

9 GROUT MATERIAL: ☐ Neat cement ☐ Cement grout ☐ Bentonite ☐ Other

Grout Intervals: From ft. to ft., From ft. to ft., From ft. to ft.

Nearest source of possible contamination: No potential source of contamination within 200 ft.☐ Septic Tank☐ Lateral Lines☐ Pit Privy☐ Livestock Pens☐ Insecticide Storage☐ Sewer Lines☐ Cess Pool☐ Sewage Lagoon☐ Fuel Storage☐ Abandoned Water Well☐ Watertight Sewer Lines☐ Seepage Pit☐ Feedyard☐ Fertilizer Storage☐ Oil Well/Gas Well☐ Other (Specify)

Direction from well? Distance from well? ft.

10 FROM TO LITHOLOGIC LOG FROM TO LITHO. LOG (cont.) or PLUGGING INTERVALS

Notes:

11 CONTRACTOR'S OR LANDOWNER'S CERTIFICATION: This water well was ☐ constructed, ☐ reconstructed, or ☐ plugged under my jurisdiction and was completed on (mo-day-year) and this record is true to the best of my knowledge and belief. Kansas Water Well Contractor's License No. This Water Well Record was completed on (mo-day-year) under the business name of

Send one copy to WATER WELL OWNER and retain one for your records. Fee of \$5.00 for each constructed well.


KS Department of Health and Environment, Bureau of Water, Geology Section, 1000 SW Jackson St., Suite 420, Topeka, Kansas 66612-1367. Telephone 785-296-3565.

Visit us at <http://www.kdheks.gov/waterwell/index.html>

KSA 82a-1212



1 inch = 114 feet

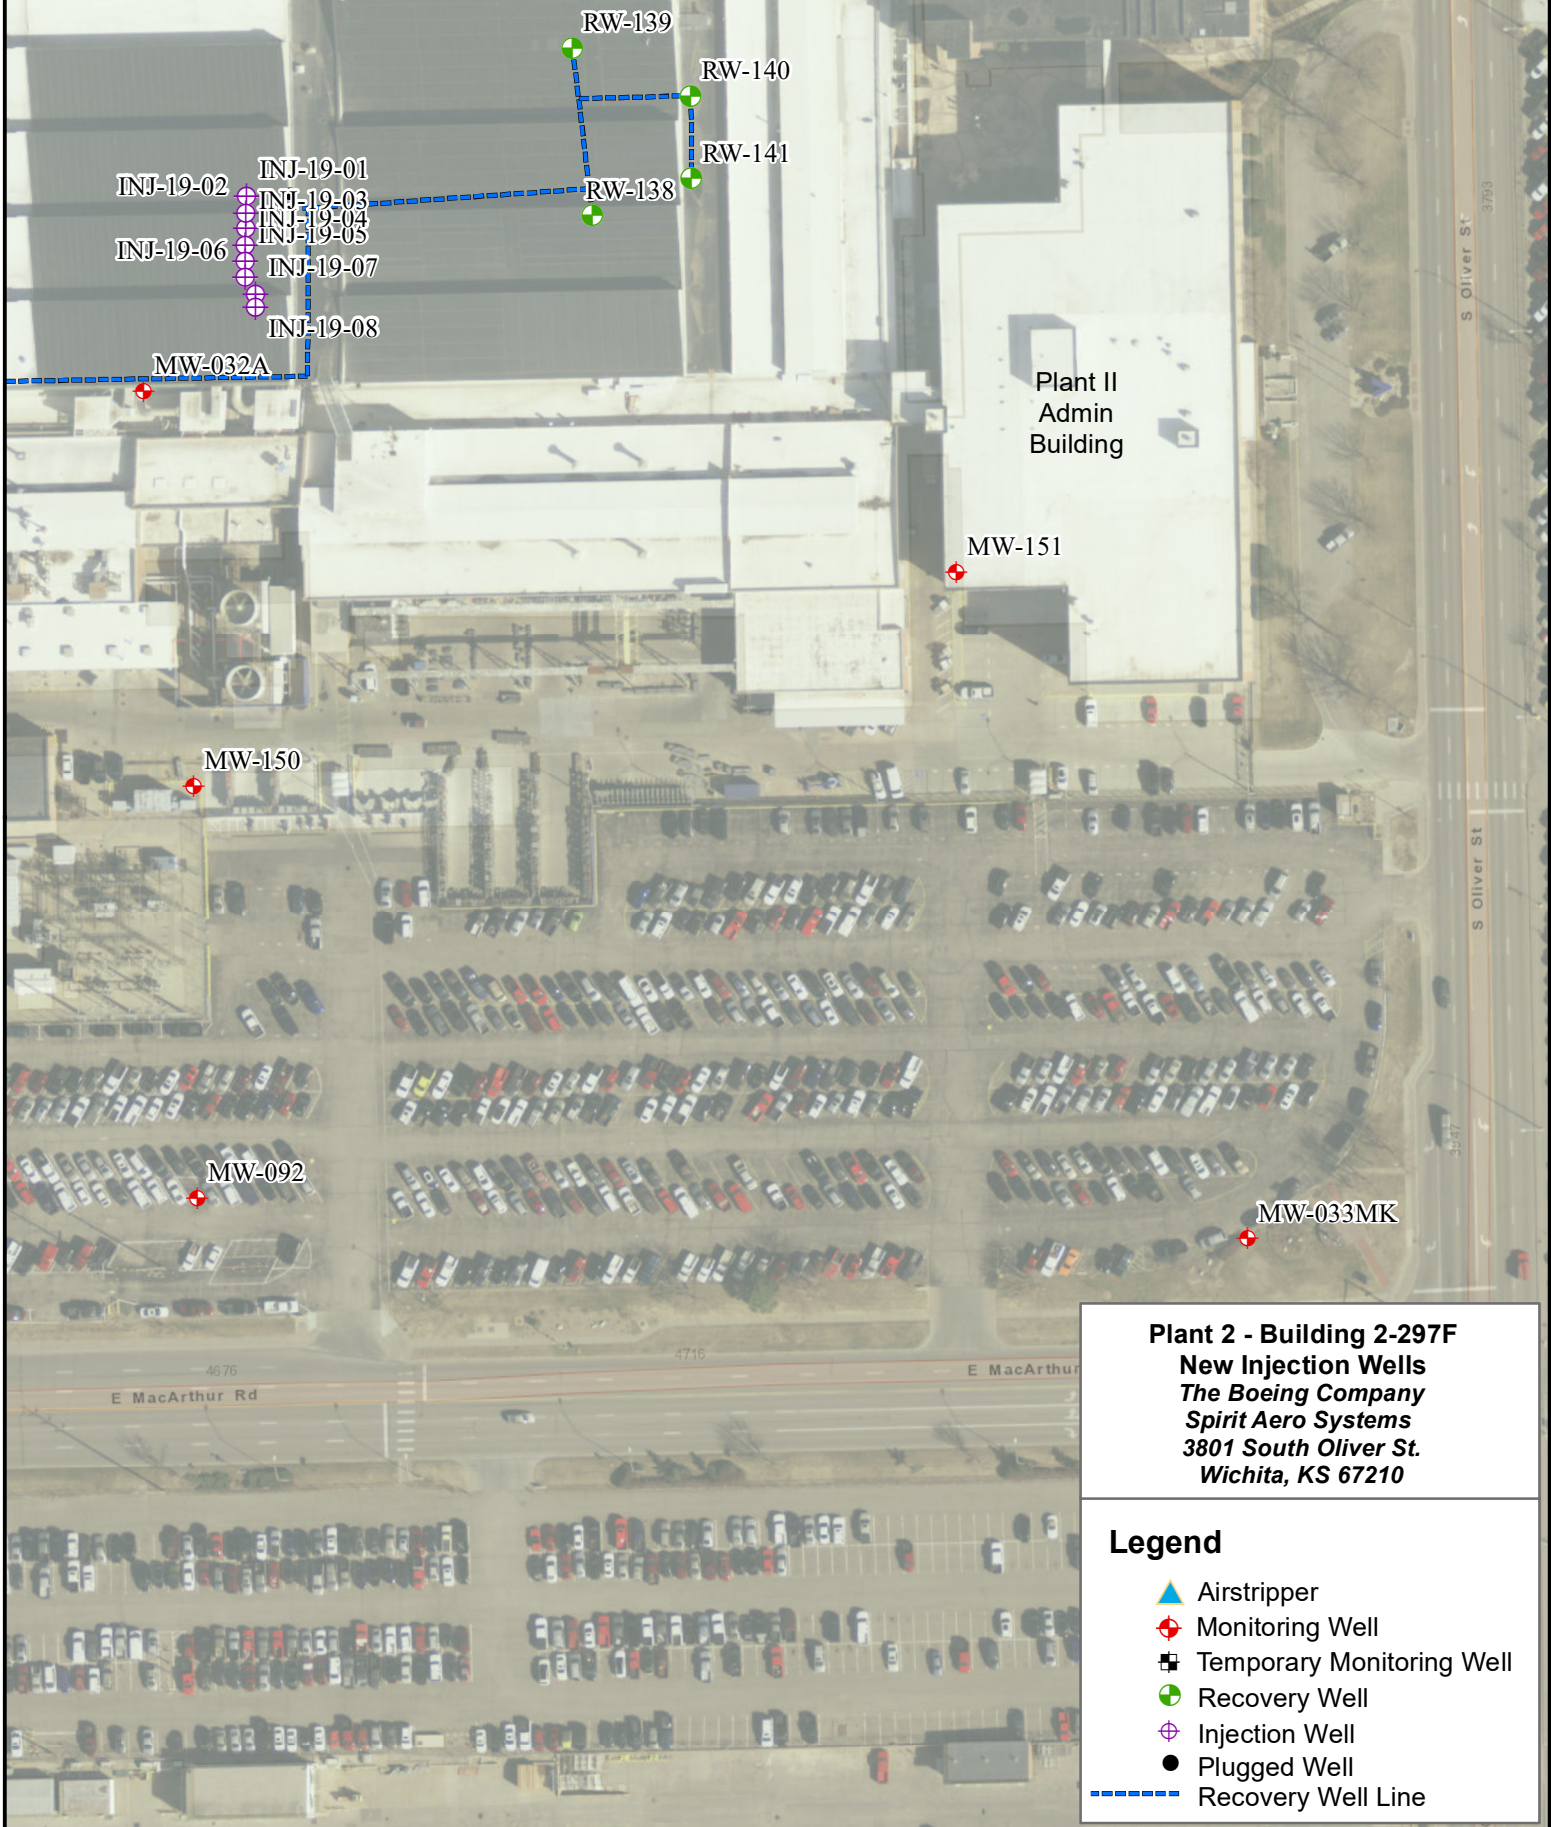

Plant 2 - Building 2-297F
New Injection Wells
The Boeing Company
Spirit Aero Systems
3801 South Oliver St.
Wichita, KS 67210

Legend

- Airstripper
- Monitoring Well
- Temporary Monitoring Well
- Recovery Well
- Injection Well
- Plugged Well
- Recovery Well Line