

WATER WELL RECORD Form WWC-5

☐ Original Record ☐ Correction ☐ Change in Well Use


Division of Water
Resources App. No.

Well ID

[illegible]



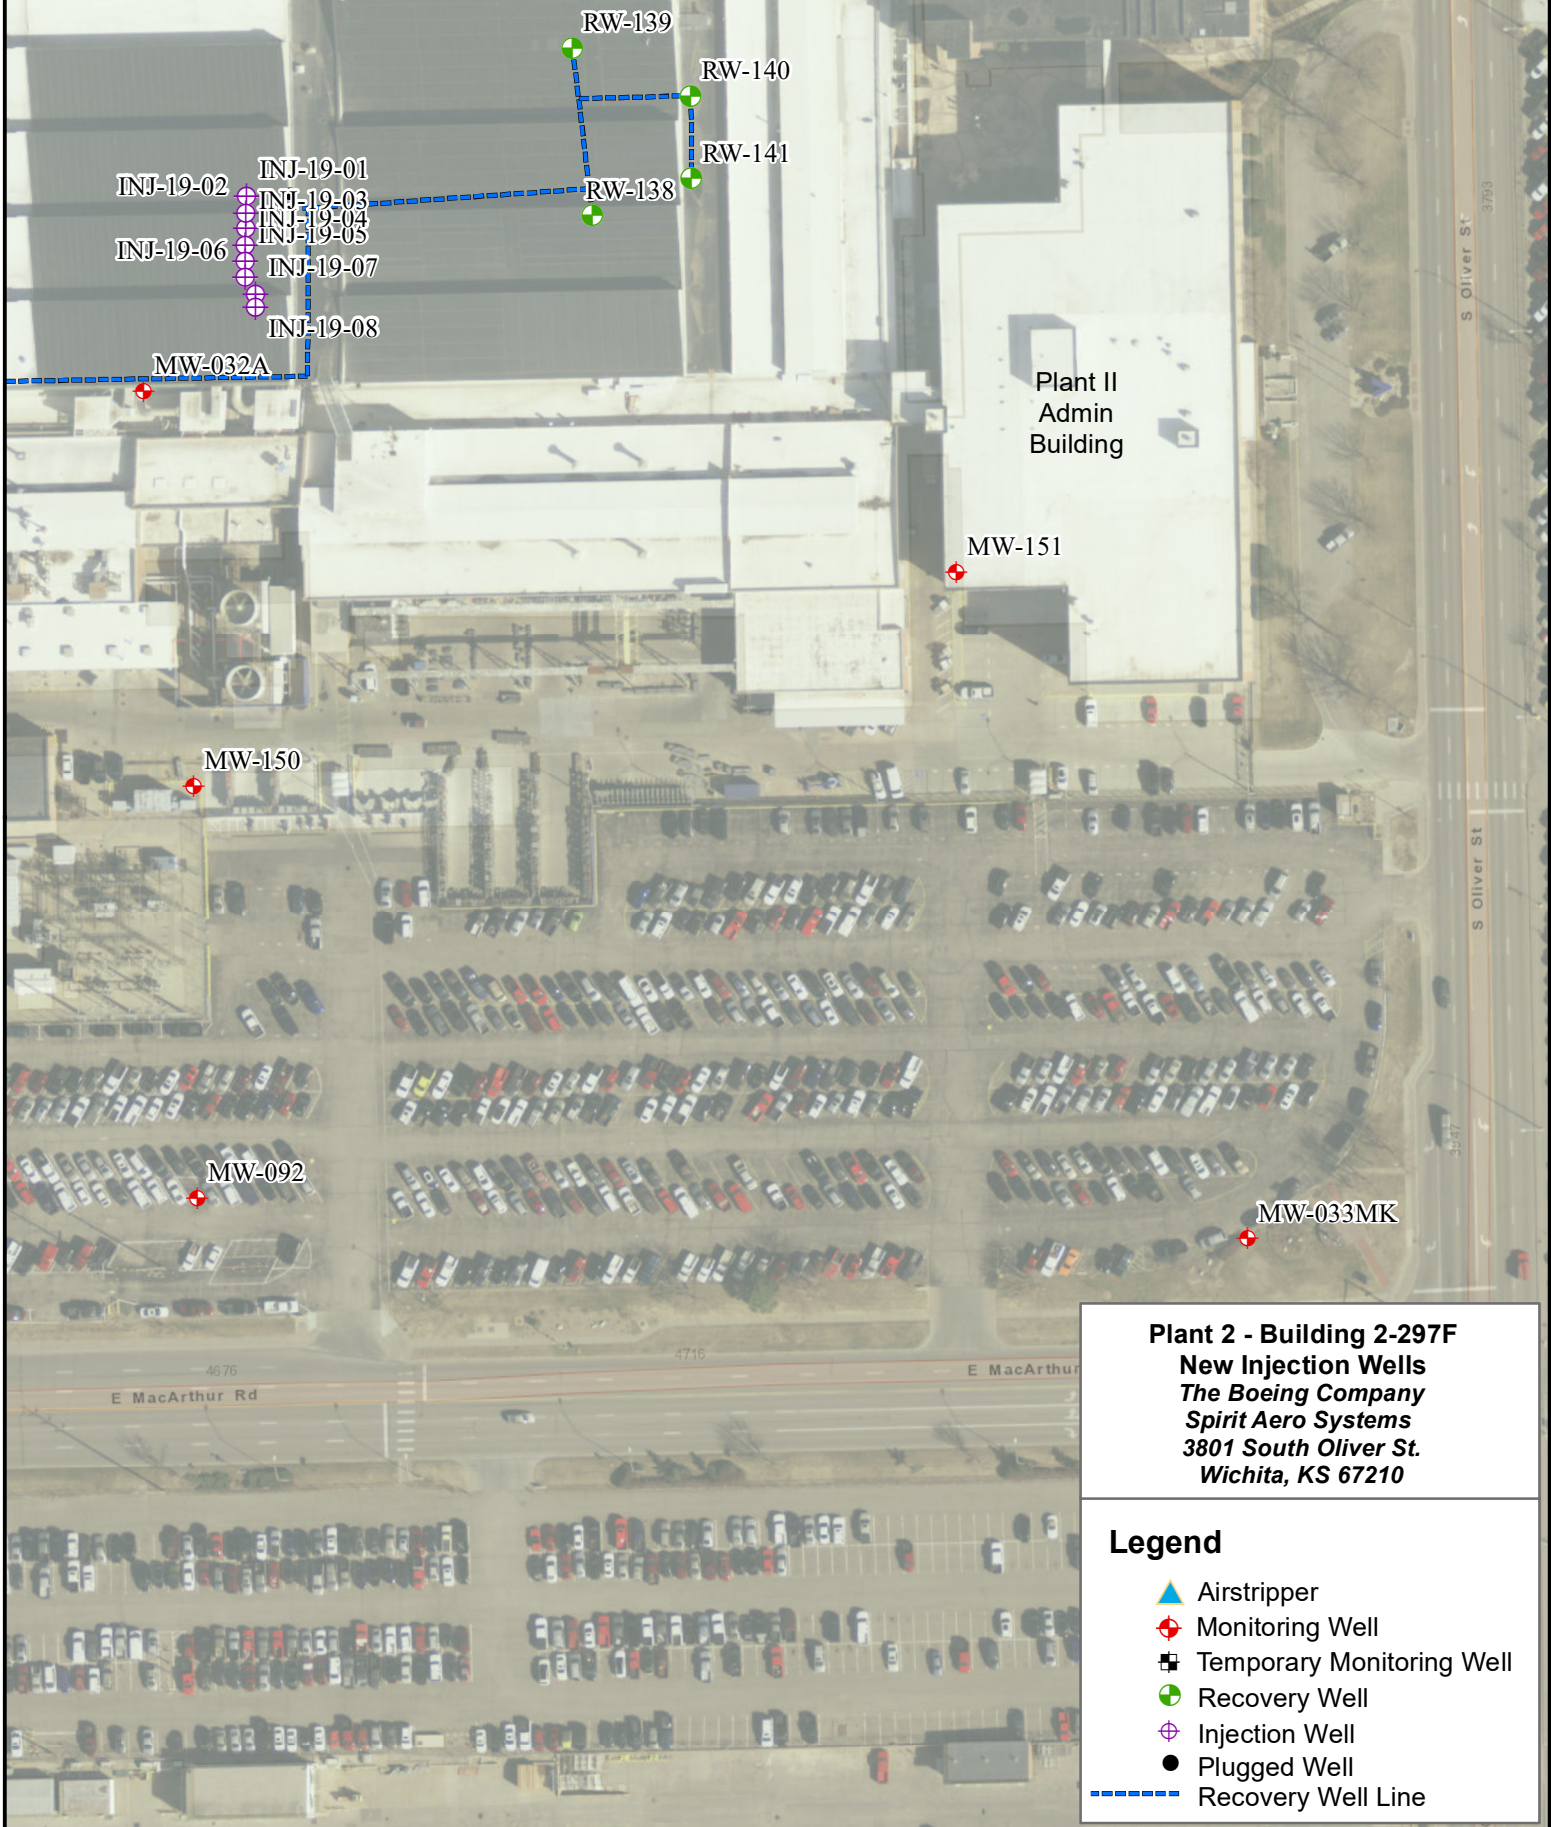


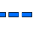



1 inch = 114 feet



Plant 2 - Building 2-297F
New Injection Wells
The Boeing Company
Spirit Aero Systems
3801 South Oliver St.
Wichita, KS 67210

Legend

-  Airstripper
-  Monitoring Well
-  Temporary Monitoring Well
-  Recovery Well
-  Injection Well
-  Plugged Well
-  Recovery Well Line