

**WATER WELL RECORD      Form WWC-5**

☐ Original Record    ☐ Correction    ☐ Change in Well Use


Division of Water  
Resources App. No.

Well ID

[illegible]





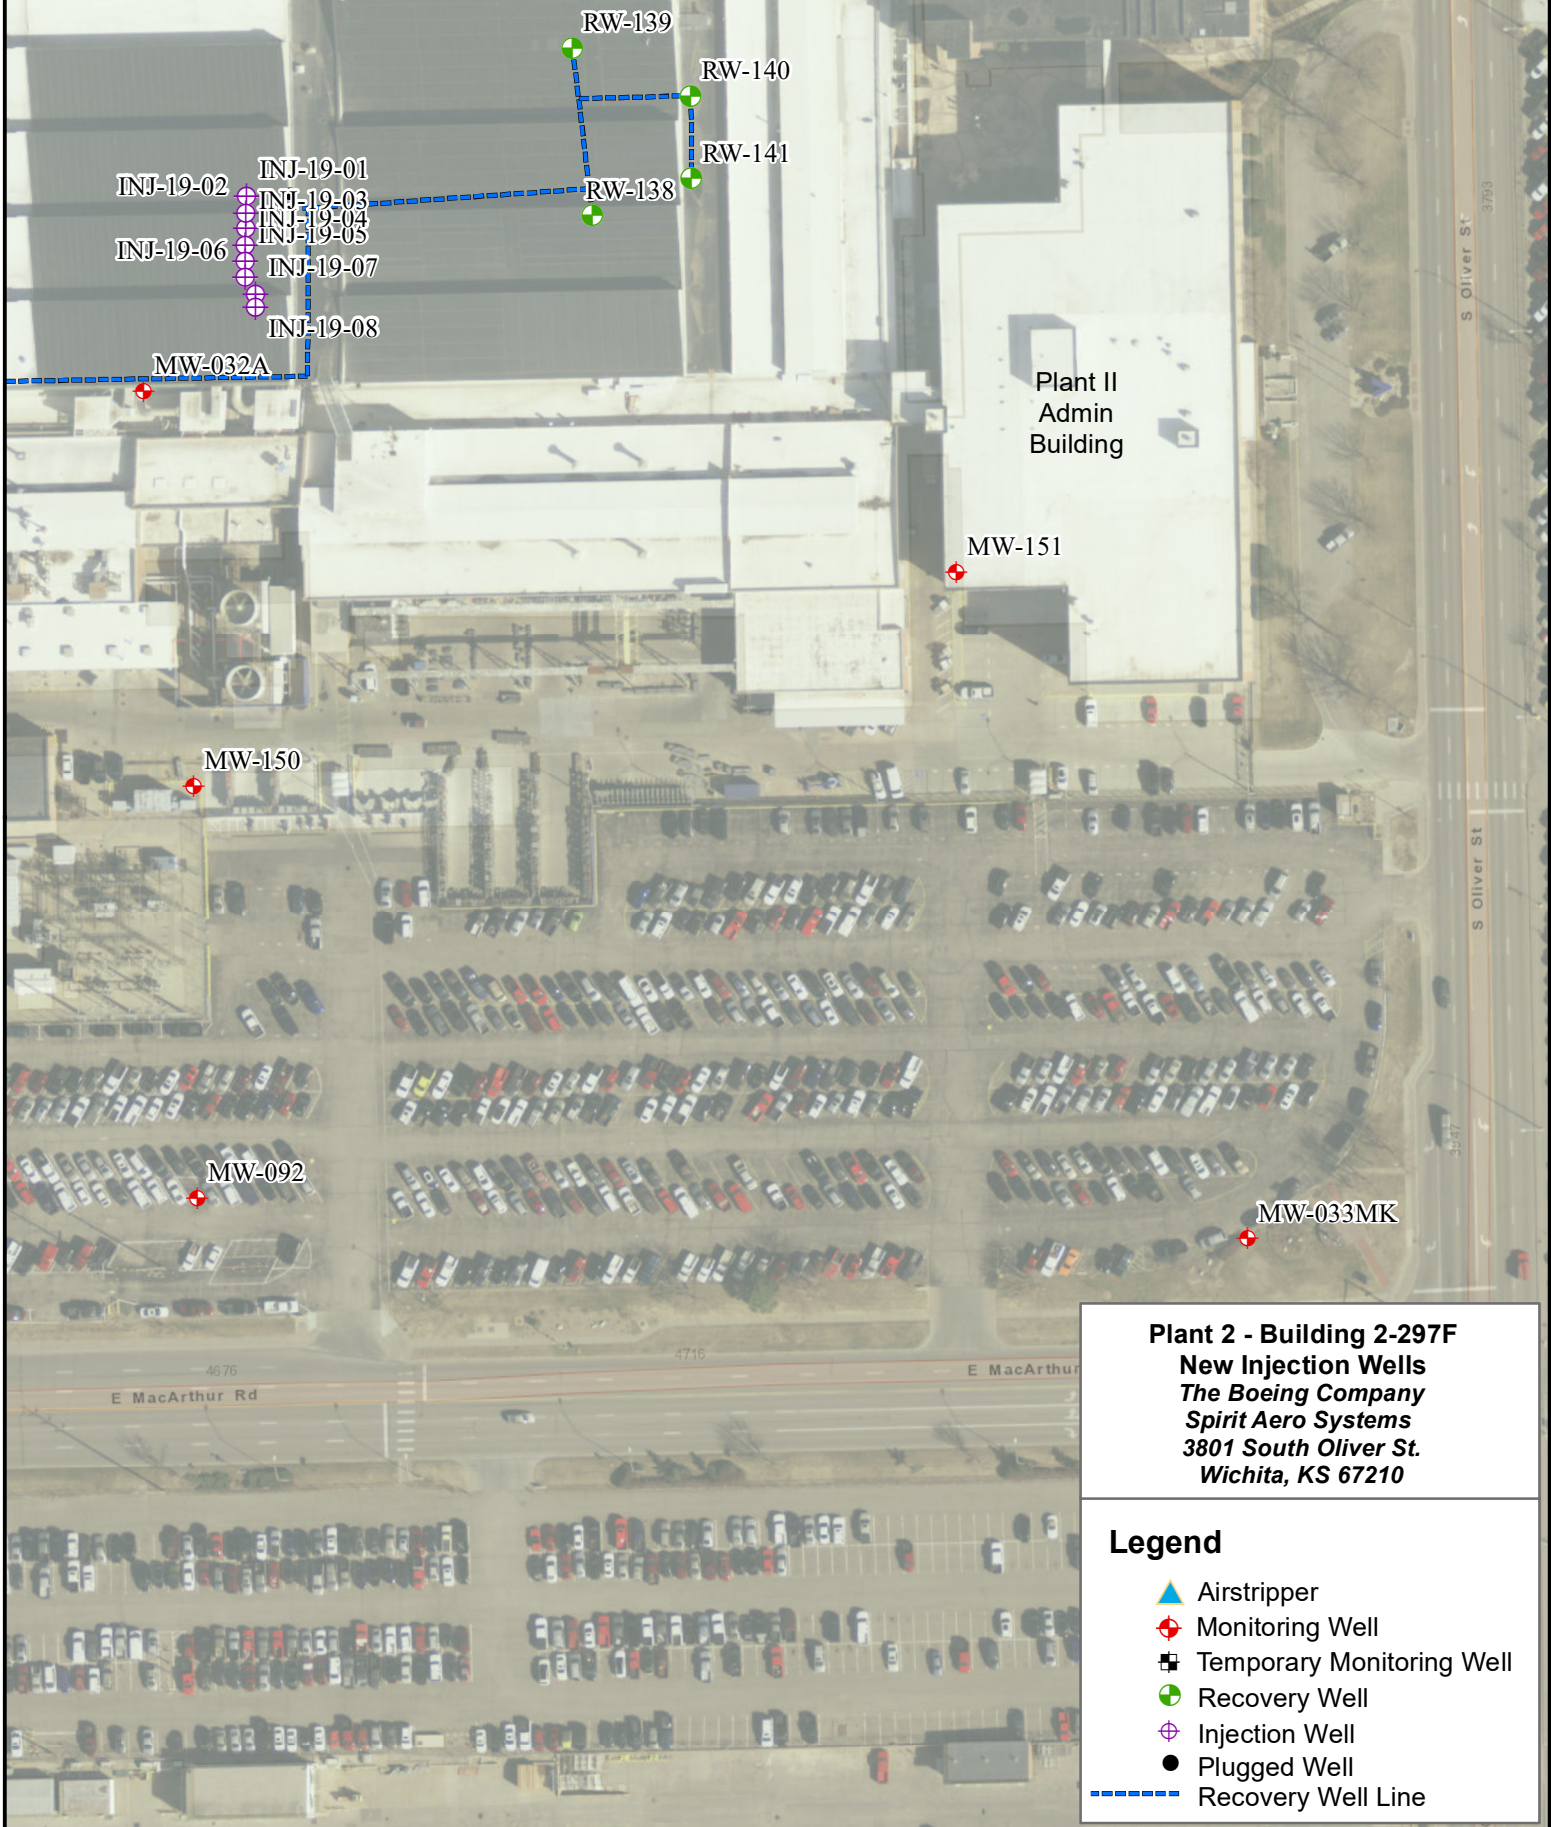




1 inch = 114 feet



**Plant 2 - Building 2-297F**  
**New Injection Wells**  
**The Boeing Company**  
**Spirit Aero Systems**  
**3801 South Oliver St.**  
**Wichita, KS 67210**

### Legend

-  Airstripper
-  Monitoring Well
-  Temporary Monitoring Well
-  Recovery Well
-  Injection Well
-  Plugged Well
-  Recovery Well Line