

**WATER WELL RECORD      Form WWC-5**


☐ Original Record    ☐ Correction    ☐ Change in Well Use

Division of Water  
Resources App. No.

Well ID

[illegible]



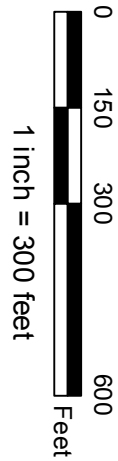

**Legend**

- = Approximate Site Boundary
- ⊕ = Existing LUST Well
- ◆ = Monitoring Well
- ◆ = Private Lawn & Garden Well
- = Cornelio Well

ALLOCATIONS AND BOUNDARIES ARE APPROXIMATE

DWG#:  
1874239

DATE:  
2019-01-11

DRAWN BY:  
CD

PROJ.MANGR:  
KW

Hillside Laundry  
2890 S. Hillside St.  
Wichita, Kansas  
C2-087-70838

**SITE BASE MAP**