

**WATER WELL PLUGGING RECORD Form WWC-5P KSA 82a-1212 ID NO.**

\_\_\_\_\_


**1 LOCATION OF WATER WELL:** County: Sedgwick Fraction: SE 1/4 NW 1/4 SE 1/4 NE 1/4 Section Number: 6 Township Number: T 28 S Range Number: 1  E  W

Street/Rural Address of Well Location; if unknown, distance & direction from nearest town or intersection: If at owner's address, check here

**Global Positioning Systems (GPS) information:**  
 Latitude: 37.64655 (in decimal degrees)  
 Longitude: 97.35536 (in decimal degrees)  
 Elevation: \_\_\_\_\_  
 Horizontal Datum:  WGS84,  NAD83,  NAD27  
 Collection Method: \_\_\_\_\_

**2 WATER WELL OWNER:** Bill Bower  
 RR#, St. Address, Box #: 1309 West Dallas  
 City, State ZIP Code: Wichita, KS, 67217

GPS unit (Make/Model): \_\_\_\_\_  
 Digital Map/Photo,  Topographic Map,  Land Survey  
 Est. Accuracy:  <3 m,  3-5 m,  5-15 m,  >15 m

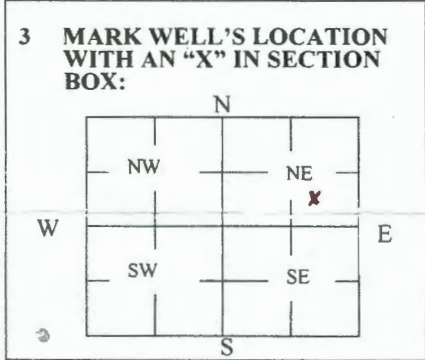

**4 DEPTH OF WELL** 23 ft.  
 WELL'S STATIC WATER LEVEL 6 19 ft  
 WELL WAS USED AS: Rain dry, no rain

Domestic  Public Water Supply  Dewatering  
 Irrigation  Oil Field Water Supply  Monitoring  
 Feedlot  Domestic (Lawn & Garden)  Injection Well  
 Industrial  Air Conditioning  Other \_\_\_\_\_

Was a chemical/bacteriological sample submitted to Department? Yes  No

**5 TYPE OF BLANK CASING USED:**

Steel  RMP (SR)  Wrought  Fiberglass  Other (Specify below)  
 PVC  ABS  Asbestos-Cement  Concrete Tile Metal

Blank casing diameter 5 1/2 in. Was casing pulled? Yes  No  If yes, how much cut off grade level  
 Casing height above or below land surface -0- in. located in basement, cement floor.

**6 GROUT PLUG MATERIAL:**  Neat cement  Cement grout  Bentonite  Other \_\_\_\_\_

Grout Plug Intervals: From 23 ft. to 2 ft., From 2 ft. to 0 ft., From \_\_\_\_\_ ft. to \_\_\_\_\_ ft.  
Cement

What is the nearest source of possible contamination:  
 Septic tank  Seepage pit  Fuel storage  Other (specify below)  
 Sewer lines  Pit privy  Fertilizer storage  
 Watertight sewer lines  Sewage lagoon  Insecticide storage  
 Lateral lines  Feedyard  Abandoned water well Direction from well? East  
 Cess pool  Livestock pens  Oil well/Gas well How many feet? 5'

FROM	TO	PLUGGING MATERIALS	FROM	TO	PLUGGING MATERIALS
<u>23</u>	<u>2</u>	<u>Bentonite</u>			
<u>2</u>	<u>0</u>	<u>Cement</u>			

**7 CONTRACTOR'S OR LANDOWNER'S CERTIFICATION:** This water well was plugged under my jurisdiction and was completed on (mo/day/year) 8/19/2019 and this record is true to the best of my knowledge and belief. Kansas Water Well Contractor's License No. 884. This Water Well Record was completed on (mo/day/year) 8/19/2019 under the business name of Weninger Drilling by (signature) Marsha Krzyzhanek

Send one white copy to Kansas Department of Health & Environment, Geology Section, 1000 SW Jackson Street, Ste. 420, Topeka, KS 66612-1367. Send one copy to WATER WELL OWNER and retain one for your records.  
 Visit us at <http://www.kdheks.gov/waterwell/index.html> Telephone 785-296-5524.