



Monitoring Well Locations 400 Ramp

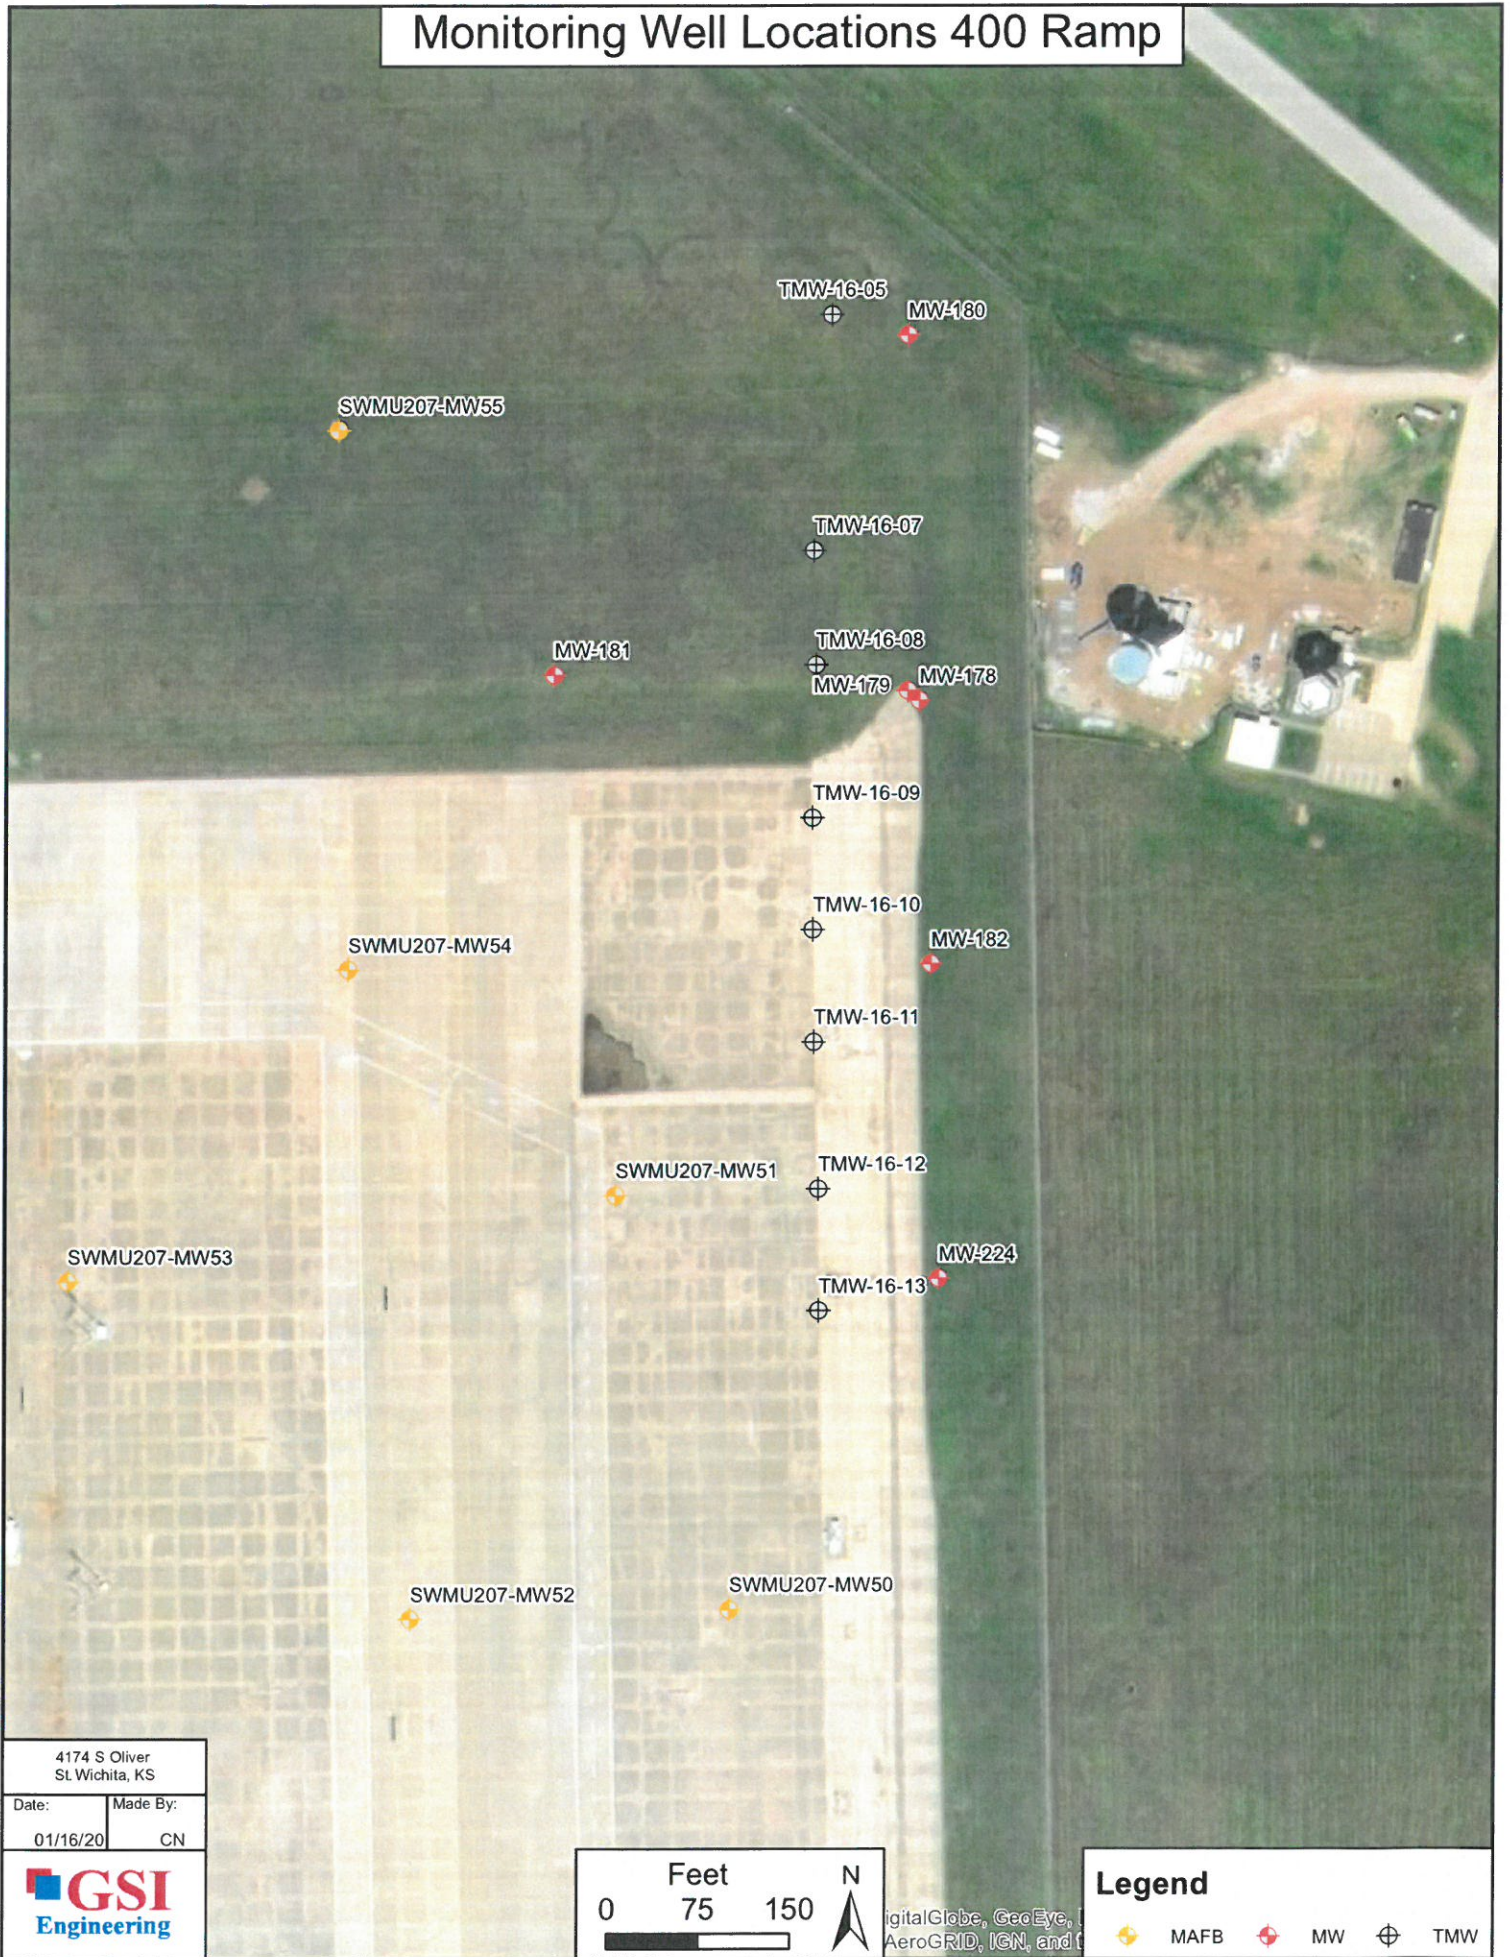

4174 S Oliver
St. Wichita, KS

Date:	Made By:
01/16/20	CN

GSI
Engineering

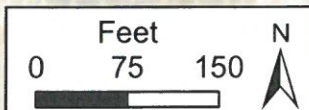

DigitalGlobe, GeoEye,
AeroGRID, IGN, and

Legend

MAFB MW TMW