

WATER WELL RECORD Form WWC-5


☐ Original Record ☐ Correction ☐ Change in Well Use

Division of Water
Resources App. No.

Well ID


1 LOCATION OF WATER WELL:		Fraction	Section Number		Township Number	Range Number																				
County:		1/4 1/4 1/4 1/4			T S	R E W																				
2 WELL OWNER: Last Name: _____ First: _____ Business: Address: City: _____ State: _____ ZIP: _____			Street or Rural Address where well is located (if unknown, distance and direction from nearest town or intersection): If at owner's address, check here: <input type="checkbox"/>																							
3 LOCATE WELL WITH "X" IN SECTION BOX: <div style="text-align:center;">N <table border="1" style="margin:auto; width:100px; height:100px;"><tr><td>-- NW --</td><td>-- NE --</td></tr><tr><td style="text-align:center;">W</td><td style="text-align:center;">E</td></tr><tr><td>-- SW --</td><td>-- SE --</td></tr><tr><td colspan="2" style="text-align:center;">S</td></tr></table> -----1 mile-----</div>		-- NW --	-- NE --	W	E	-- SW --	-- SE --	S		4 DEPTH OF COMPLETED WELL: ft. Depth(s) Groundwater Encountered: 1) ft. 2) ft. 3) ft., or 4) <input type="checkbox"/> Dry Well WELL'S STATIC WATER LEVEL: ft. <input type="checkbox"/> below land surface, measured on (mo-day-yr)..... <input type="checkbox"/> above land surface, measured on (mo-day-yr)..... Pump test data: Well water was ft. after hours pumping gpm Well water was ft. after hours pumping gpm Estimated Yield:gpm Bore Hole Diameter: in. to ft. and in. to ft.		5 Latitude:(decimal degrees) Longitude:(decimal degrees) Datum: <input type="checkbox"/> WGS 84 <input type="checkbox"/> NAD 83 <input type="checkbox"/> NAD 27 <u>Source for Latitude/Longitude:</u> <input type="checkbox"/> GPS (unit make/model:) (WAAS enabled? <input type="checkbox"/> Yes <input type="checkbox"/> No) <input type="checkbox"/> Land Survey <input type="checkbox"/> Topographic Map <input type="checkbox"/> Online Mapper:														
-- NW --	-- NE --																									
W	E																									
-- SW --	-- SE --																									
S																										
7 WELL WATER TO BE USED AS: <table style="width:100%;"><tr><td>1. Domestic: <input type="checkbox"/> Household <input type="checkbox"/> Lawn & Garden <input type="checkbox"/> Livestock</td><td>5. <input type="checkbox"/> Public Water Supply: well ID</td><td>10. <input type="checkbox"/> Oil Field Water Supply: lease</td></tr><tr><td>2. <input type="checkbox"/> Irrigation</td><td>6. <input type="checkbox"/> Dewatering: how many wells?</td><td>11. Test Hole: well ID <input type="checkbox"/> Cased <input type="checkbox"/> Uncased <input type="checkbox"/> Geotechnical</td></tr><tr><td>3. <input type="checkbox"/> Feedlot</td><td>7. <input type="checkbox"/> Aquifer Recharge: well ID</td><td>12. Geothermal: how many bores? a) Closed Loop <input type="checkbox"/> Horizontal <input type="checkbox"/> Vertical</td></tr><tr><td>4. <input type="checkbox"/> Industrial</td><td>8. <input type="checkbox"/> Monitoring: well ID</td><td>b) Open Loop <input type="checkbox"/> Surface Discharge <input type="checkbox"/> Inj. of Water</td></tr><tr><td></td><td>9. Environmental Remediation: well ID <input type="checkbox"/> Air Sparge <input type="checkbox"/> Soil Vapor Extraction <input type="checkbox"/> Recovery <input type="checkbox"/> Injection</td><td>13. <input type="checkbox"/> Other (specify):</td></tr>
Was a chemical/bacteriological sample submitted to KDHE? <input type="checkbox"/> Yes <input type="checkbox"/> No If yes, date sample was submitted:																										
Water well disinfected? <input type="checkbox"/> Yes <input type="checkbox"/> No																										
8 TYPE OF CASING USED: <input type="checkbox"/> Steel <input type="checkbox"/> PVC <input type="checkbox"/> Other CASING JOINTS: <input type="checkbox"/> Glued <input type="checkbox"/> Clamped <input type="checkbox"/> Welded <input type="checkbox"/> Threaded Casing diameter in. to ft., Diameter in. to ft., Diameter in. to ft. Casing height above land surface in. Weight lbs./ft. Wall thickness or gauge No.																										
TYPE OF SCREEN OR PERFORATION MATERIAL: <input type="checkbox"/> Steel <input type="checkbox"/> Stainless Steel <input type="checkbox"/> PVC <input type="checkbox"/> Other (Specify) <input type="checkbox"/> Brass <input type="checkbox"/> Galvanized Steel <input type="checkbox"/> None used (open hole)																										
SCREEN OR PERFORATION OPENINGS ARE: <input type="checkbox"/> Continuous Slot <input type="checkbox"/> Mill Slot <input type="checkbox"/> Gauze Wrapped <input type="checkbox"/> Torch Cut <input type="checkbox"/> Drilled Holes <input type="checkbox"/> Other (Specify) <input type="checkbox"/> Louvered Shutter <input type="checkbox"/> Key Punched <input type="checkbox"/> Wire Wrapped <input type="checkbox"/> Saw Cut <input type="checkbox"/> None (Open Hole)																										
SCREEN-PERFORATED INTERVALS: From ft. to ft., From ft. to ft., From ft. to ft. GRAVEL PACK INTERVALS: From ft. to ft., From ft. to ft., From ft. to ft.																										
9 GROUT MATERIAL: <input type="checkbox"/> Neat cement <input type="checkbox"/> Cement grout <input type="checkbox"/> Bentonite <input type="checkbox"/> Other Grout Intervals: From ft. to ft., From ft. to ft., From ft. to ft. Nearest source of possible contamination: No potential source of contamination within 200 ft. <table style="width:100%;"><tr><td><input type="checkbox"/> Septic Tank</td><td><input type="checkbox"/> Lateral Lines</td><td><input type="checkbox"/> Pit Privy</td><td><input type="checkbox"/> Livestock Pens</td><td><input type="checkbox"/> Insecticide Storage</td></tr><tr><td><input type="checkbox"/> Sewer Lines</td><td><input type="checkbox"/> Cess Pool</td><td><input type="checkbox"/> Sewage Lagoon</td><td><input type="checkbox"/> Fuel Storage</td><td><input type="checkbox"/> Abandoned Water Well</td></tr><tr><td><input type="checkbox"/> Watertight Sewer Lines</td><td><input type="checkbox"/> Seepage Pit</td><td><input type="checkbox"/> Feedyard</td><td><input type="checkbox"/> Fertilizer Storage</td><td><input type="checkbox"/> Oil Well/Gas Well</td></tr><tr><td colspan="5"><input type="checkbox"/> Other (Specify)</td></tr></table> Direction from well? Distance from well? ft.							<input type="checkbox"/> Septic Tank	<input type="checkbox"/> Lateral Lines	<input type="checkbox"/> Pit Privy	<input type="checkbox"/> Livestock Pens	<input type="checkbox"/> Insecticide Storage	<input type="checkbox"/> Sewer Lines	<input type="checkbox"/> Cess Pool	<input type="checkbox"/> Sewage Lagoon	<input type="checkbox"/> Fuel Storage	<input type="checkbox"/> Abandoned Water Well	<input type="checkbox"/> Watertight Sewer Lines	<input type="checkbox"/> Seepage Pit	<input type="checkbox"/> Feedyard	<input type="checkbox"/> Fertilizer Storage	<input type="checkbox"/> Oil Well/Gas Well	<input type="checkbox"/> Other (Specify)				
<input type="checkbox"/> Septic Tank	<input type="checkbox"/> Lateral Lines	<input type="checkbox"/> Pit Privy	<input type="checkbox"/> Livestock Pens	<input type="checkbox"/> Insecticide Storage																						
<input type="checkbox"/> Sewer Lines	<input type="checkbox"/> Cess Pool	<input type="checkbox"/> Sewage Lagoon	<input type="checkbox"/> Fuel Storage	<input type="checkbox"/> Abandoned Water Well																						
<input type="checkbox"/> Watertight Sewer Lines	<input type="checkbox"/> Seepage Pit	<input type="checkbox"/> Feedyard	<input type="checkbox"/> Fertilizer Storage	<input type="checkbox"/> Oil Well/Gas Well																						
<input type="checkbox"/> Other (Specify)																										
10 FROM	TO	LITHOLOGIC LOG	FROM	TO	LITHO. LOG (cont.) or PLUGGING INTERVALS																					
			Notes:																							
11 CONTRACTOR'S OR LANDOWNER'S CERTIFICATION: This water well was <input type="checkbox"/> constructed, <input type="checkbox"/> reconstructed, or <input type="checkbox"/> plugged under my jurisdiction and was completed on (mo-day-year) and this record is true to the best of my knowledge and belief. Kansas Water Well Contractor's License No. This Water Well Record was completed on (mo-day-year) under the business name of																										
Send one copy to WATER WELL OWNER and retain one for your records. Fee of \$5.00 for each <u>constructed</u> well. KS Department of Health and Environment, Bureau of Water, Geology Section, 1000 SW Jackson St., Suite 420, Topeka, Kansas 66612-1367. Telephone 785-296-3565. Visit us at http://www.kdheks.gov/waterwell/index.html KSA 82a-1212																										

Monitoring Well Locations 400 Ramp

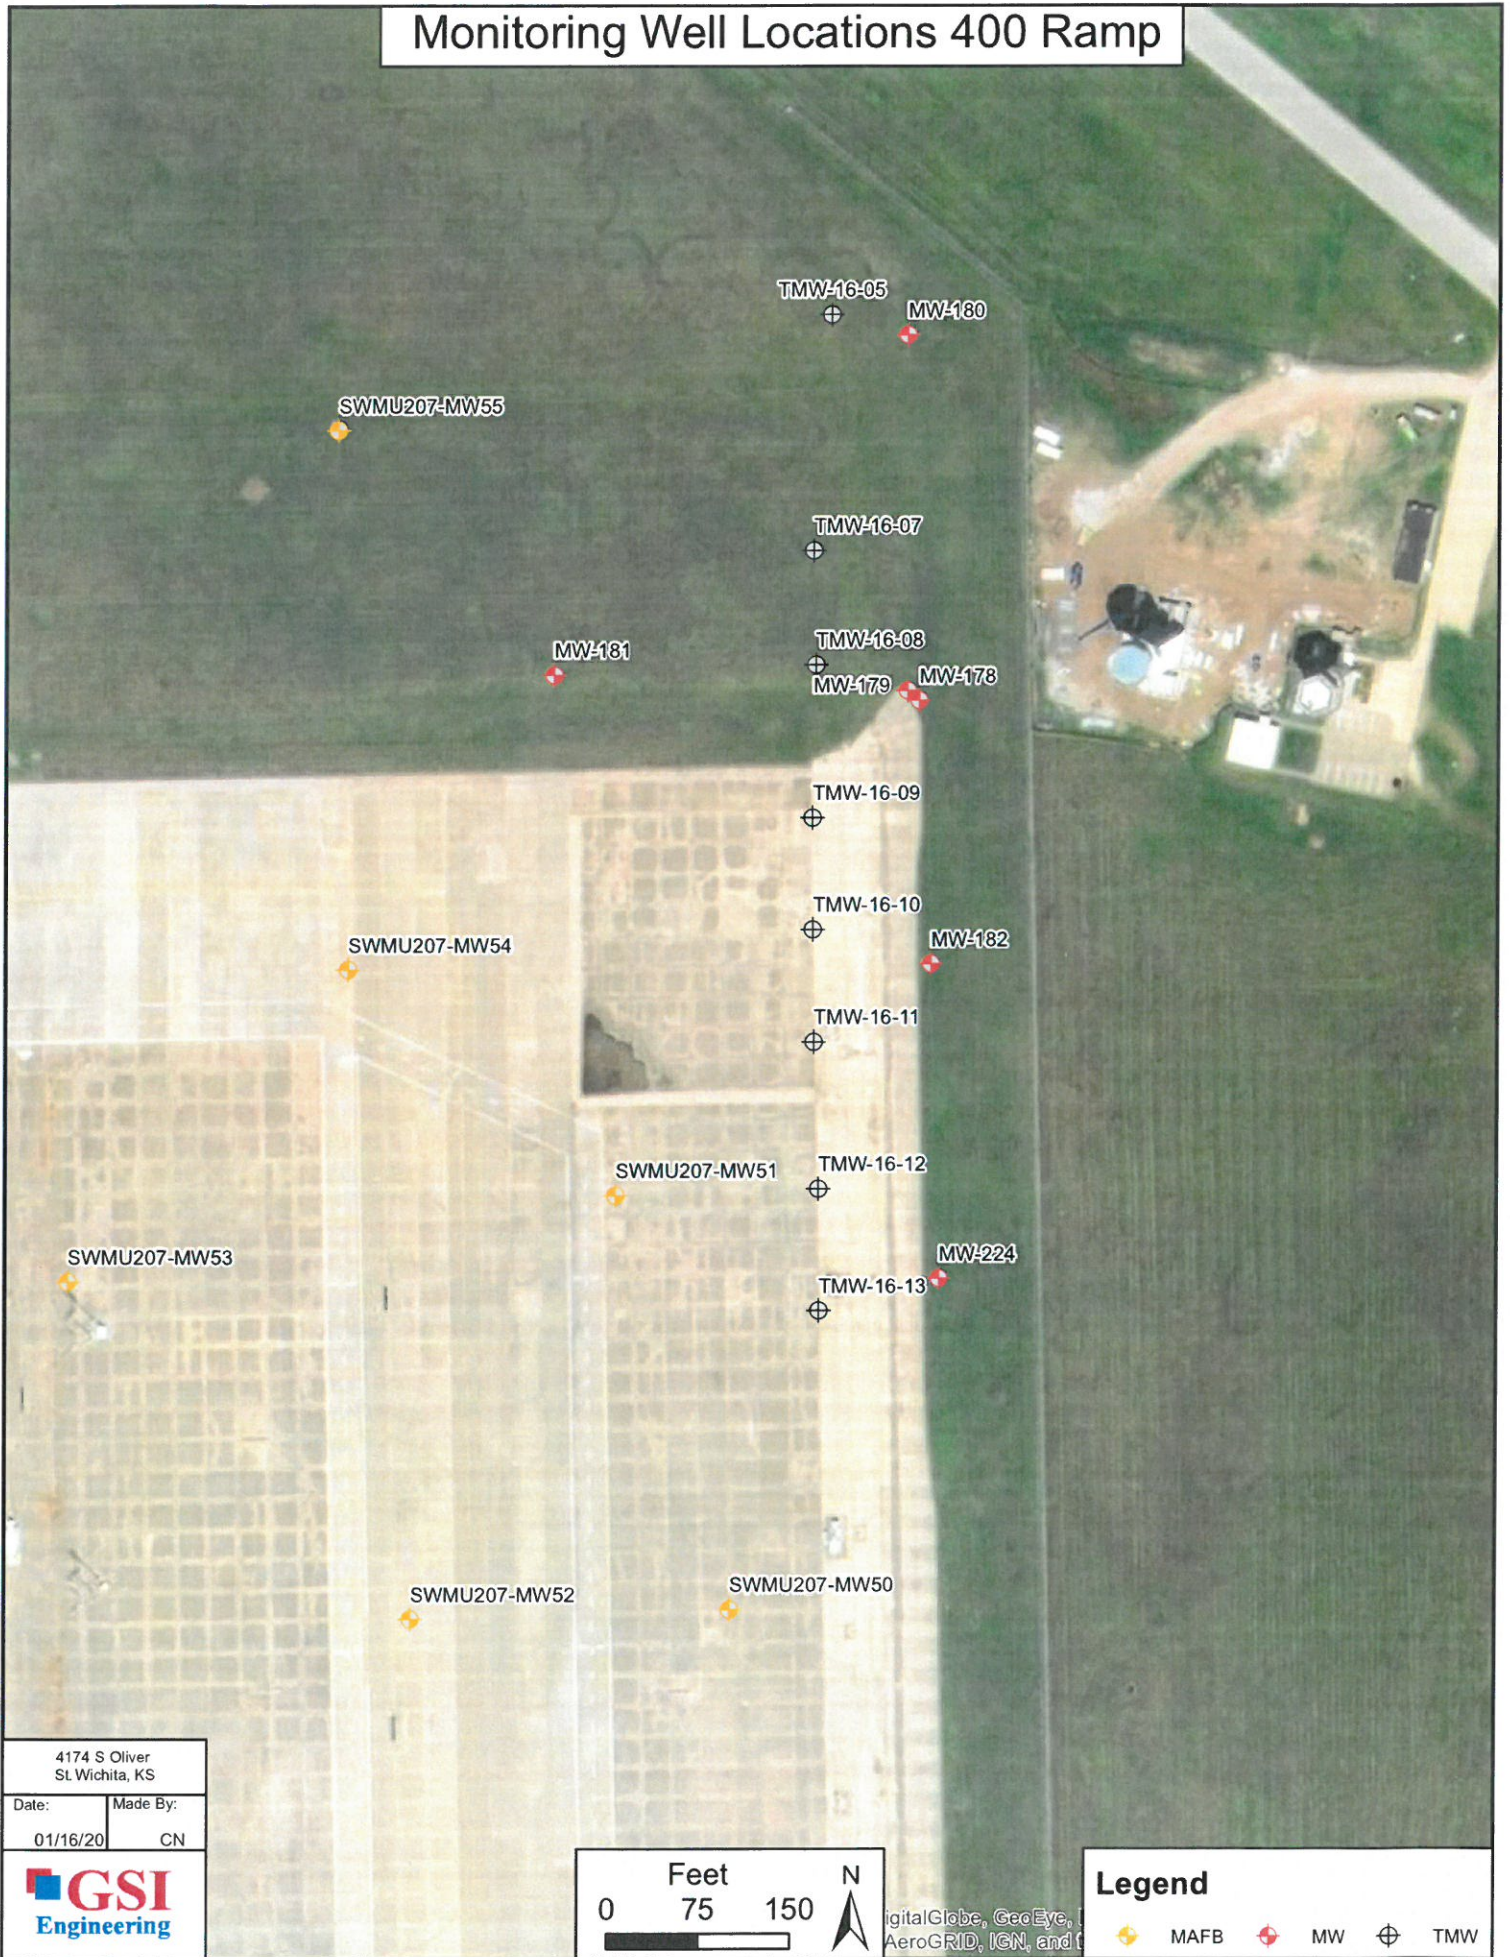

4174 S Oliver St. Wichita, KS	
Date:	Made By:
01/16/20	CN

GSI
Engineering

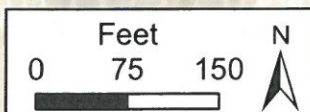

DigitalGlobe, GeoEye,
AeroGRID, IGN, and

Legend

MAFB MW TMW