

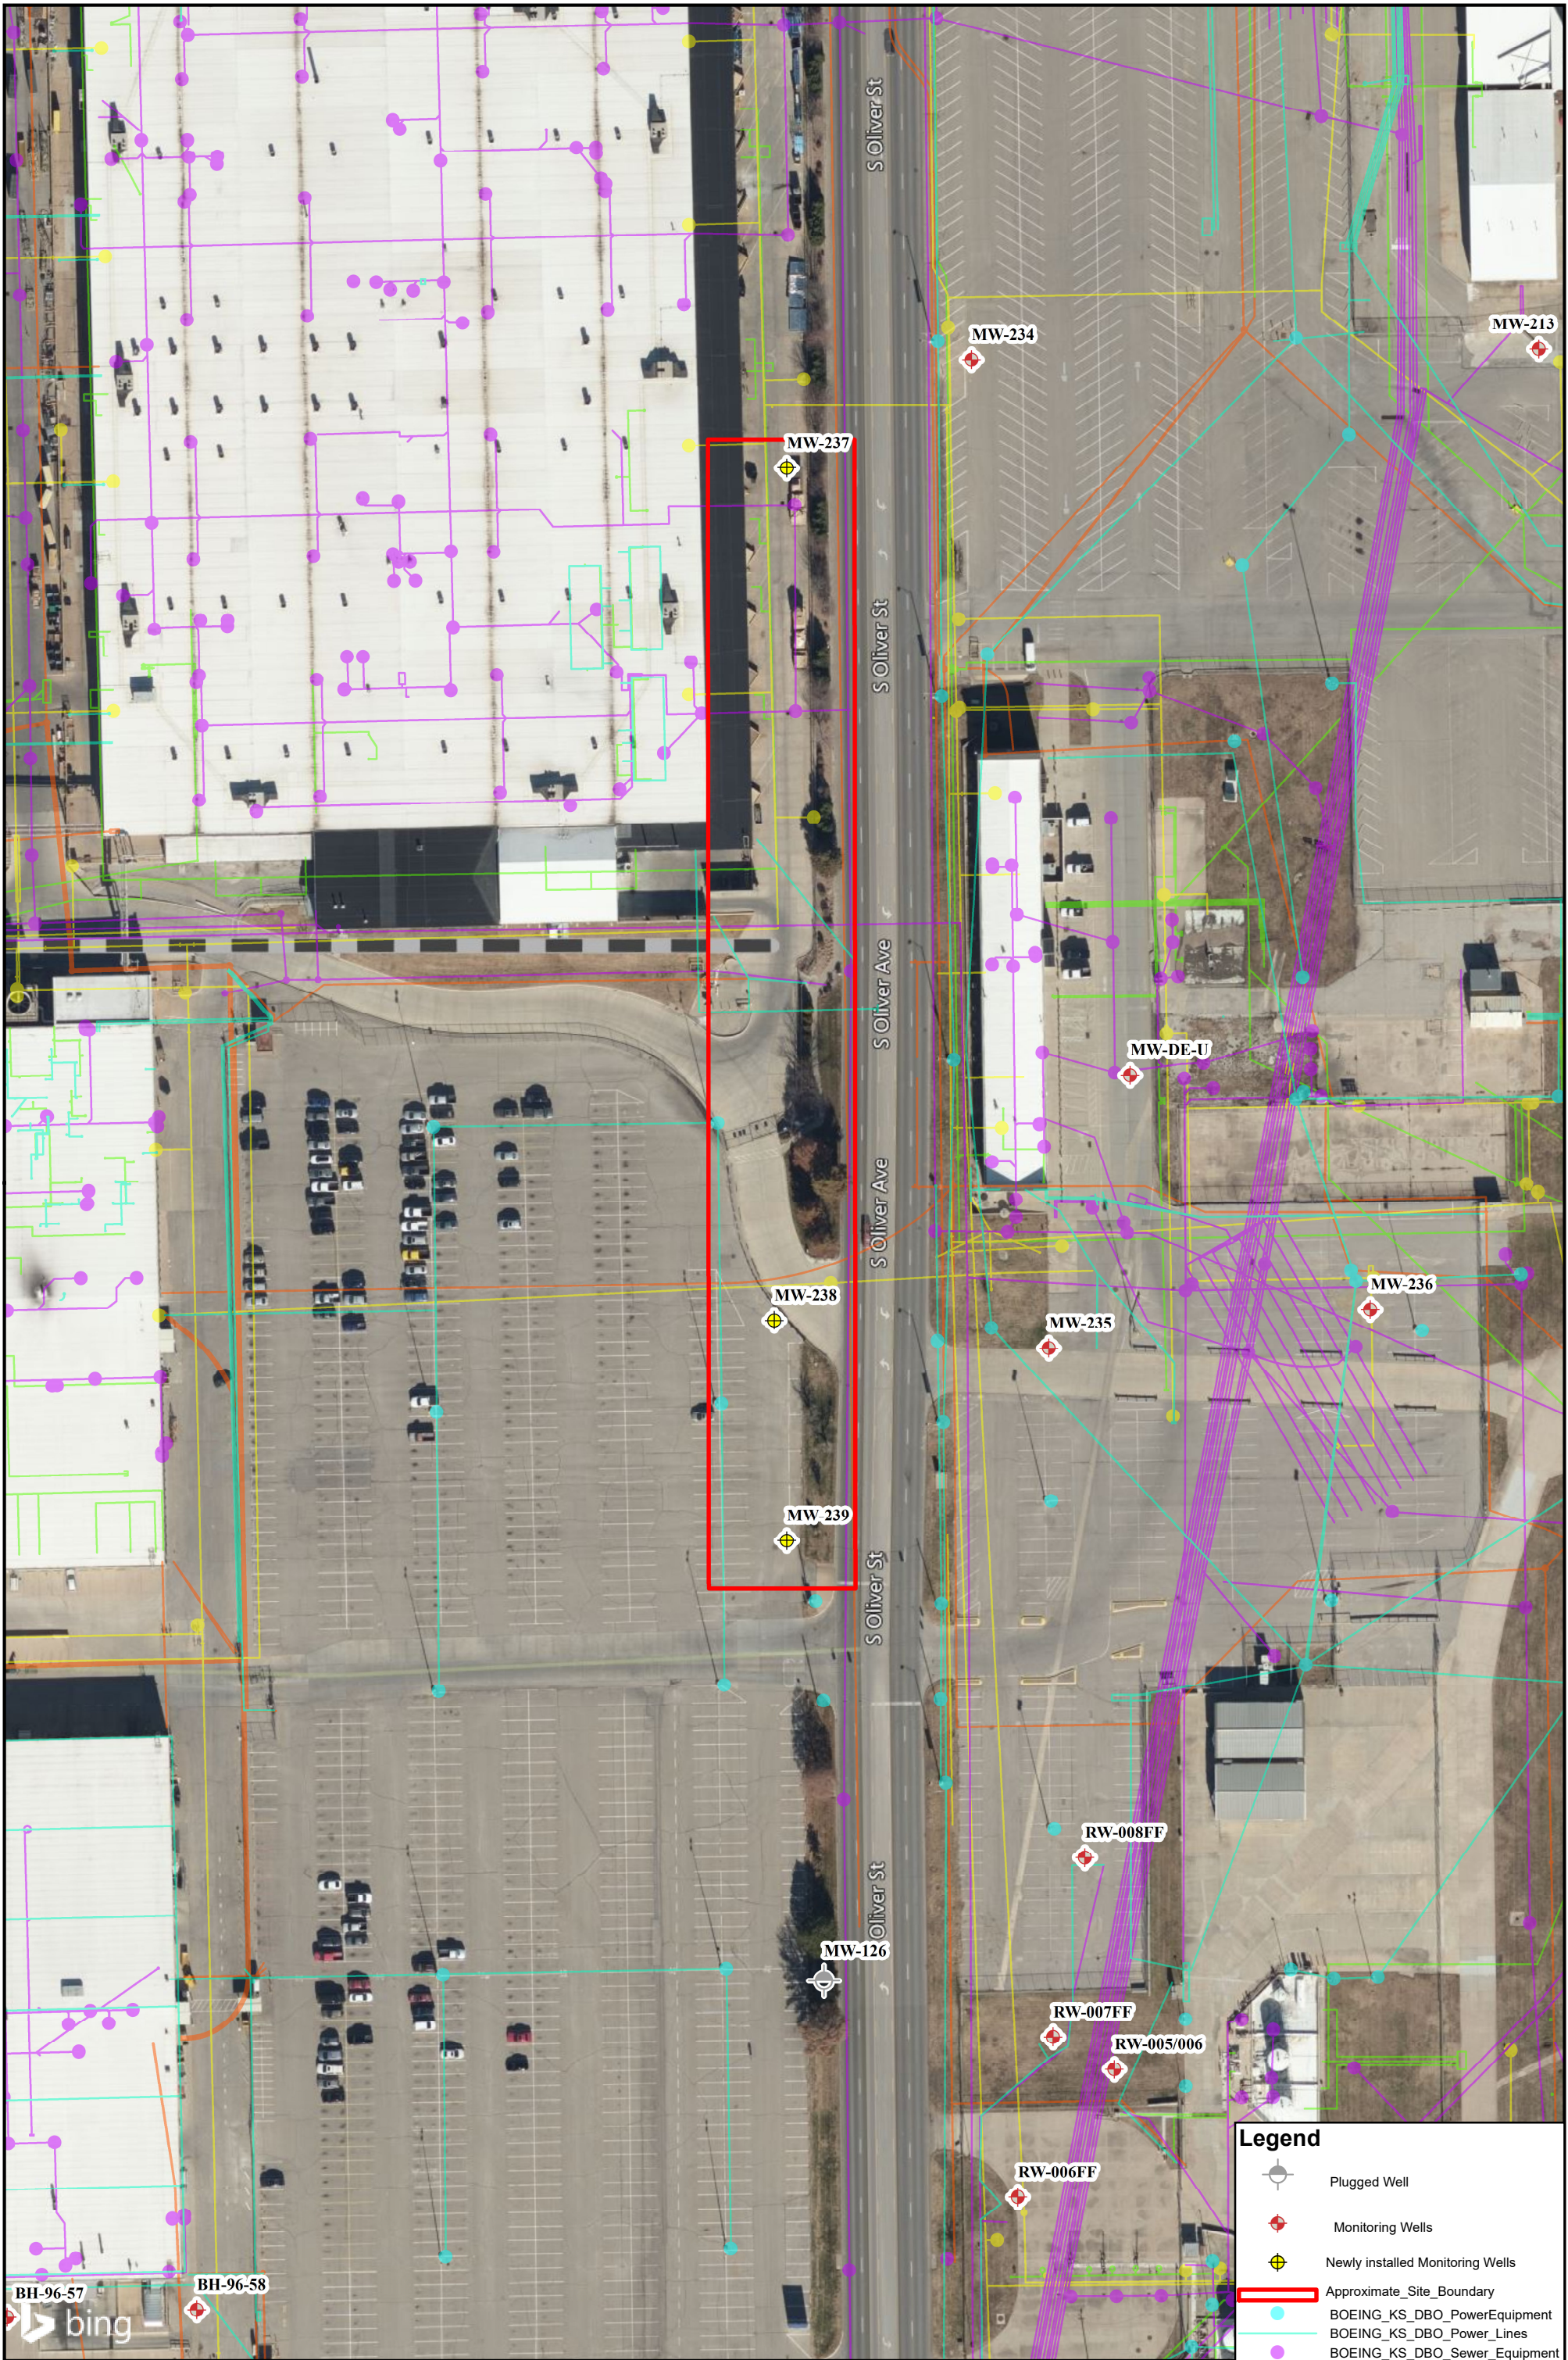


	FIGURE: 2.0	FIGURE NAME: Oliver Well Location Map	 0 Feet 100 SCALE: 1" = 100'
	DATE: 06/22/2021	PROJECT NUMBER: 147550	
	DRAWN BY: PM	PROJECT MANAGER: A. Chadd	
		Spirit Aerosystems 3801 S. Oliver Wichita, KS 67210	