

WATER WELL RECORD Form WWC-5

☐ Original Record ☐ Correction ☐ Change in Well Use

Division of Water
Resources App. No.

Well ID

1 LOCATION OF WATER WELL:		Fraction	Section Number		Township Number	Range Number									
County:		1/4 1/4 1/4 1/4			T S	R E W									
2 WELL OWNER: Last Name:			First:		Street or Rural Address where well is located (if unknown, distance and direction from nearest town or intersection): If at owner's address, check here: ☐										
Business: Address: City:			State: ZIP:												
3 LOCATE WELL WITH "X" IN SECTION BOX: N <table border="1" style="margin: auto;"><tr><td>-- NW --</td><td>-- NE --</td></tr><tr><td style="text-align: right;">W</td><td style="text-align: left;">E</td></tr><tr><td>-- SW --</td><td>-- SE --</td></tr><tr><td colspan="2" style="text-align: center;">S</td></tr></table> -----1 mile-----		-- NW --	-- NE --	W	E	-- SW --	-- SE --	S		4 DEPTH OF COMPLETED WELL: ft. Depth(s) Groundwater Encountered: 1) ft. 2) ft. 3) ft., or 4) ☐ Dry Well WELL'S STATIC WATER LEVEL: ft. ☐ below land surface, measured on (mo-day-yr)..... ☐ above land surface, measured on (mo-day-yr)..... Pump test data: Well water was ft. after..... hours pumping gpm Well water was ft. after..... hours pumping gpm Estimated Yield:gpm Bore Hole Diameter: in. to ft. and in. to ft.			5 Latitude:(decimal degrees) Longitude:(decimal degrees) Datum: ☐ WGS 84 ☐ NAD 83 ☐ NAD 27 <u>Source for Latitude/Longitude:</u> ☐ GPS (unit make/model:)(WAAS enabled? ☐ Yes ☐ No) ☐ Land Survey ☐ Topographic Map ☐ Online Mapper: 6 Elevation:ft. ☐ Ground Level ☐ TOC <u>Source:</u> ☐ Land Survey ☐ GPS ☐ Topographic Map ☐ Other		
-- NW --	-- NE --														
W	E														
-- SW --	-- SE --														
S															
7 WELL WATER TO BE USED AS:															
1. Domestic: ☐ Household ☐ Lawn & Garden ☐ Livestock 2. ☐ Irrigation 3. ☐ Feedlot 4. ☐ Industrial 5. ☐ Public Water Supply: well ID 6. ☐ Dewatering: how many wells? 7. ☐ Aquifer Recharge: well ID 8. ☐ Monitoring: well ID 9. Environmental Remediation: well ID ☐ Air Sparge ☐ Soil Vapor Extraction ☐ Recovery ☐ Injection 10. ☐ Oil Field Water Supply: lease 11. Test Hole: well ID ☐ Cased ☐ Uncased ☐ Geotechnical 12. Geothermal: how many bores? a) Closed Loop ☐ Horizontal ☐ Vertical b) Open Loop ☐ Surface Discharge ☐ Inj. of Water 13. ☐ Other (specify):															
Was a chemical/bacteriological sample submitted to KDHE? ☐ Yes ☐ No If yes, date sample was submitted:															
Water well disinfected? ☐ Yes ☐ No															
8 TYPE OF CASING USED: ☐ Steel ☐ PVC ☐ Other CASING JOINTS: ☐ Glued ☐ Clamped ☐ Welded ☐ Threaded Casing diameter in. to ft., Diameter in. to ft., Diameter in. to ft. Casing height above land surface in. Weight lbs./ft. Wall thickness or gauge No.															
TYPE OF SCREEN OR PERFORATION MATERIAL: ☐ Steel ☐ Stainless Steel ☐ PVC ☐ Other (Specify) ☐ Brass ☐ Galvanized Steel ☐ None used (open hole)															
SCREEN OR PERFORATION OPENINGS ARE: ☐ Continuous Slot ☐ Mill Slot ☐ Gauze Wrapped ☐ Torch Cut ☐ Drilled Holes ☐ Other (Specify) ☐ Louvered Shutter ☐ Key Punched ☐ Wire Wrapped ☐ Saw Cut ☐ None (Open Hole)															
SCREEN-PERFORATED INTERVALS: From ft. to ft., From ft. to ft., From ft. to ft. GRAVEL PACK INTERVALS: From ft. to ft., From ft. to ft., From ft. to ft.															
9 GROUT MATERIAL: ☐ Neat cement ☐ Cement grout ☐ Bentonite ☐ Other Grout Intervals: From ft. to ft., From ft. to ft., From ft. to ft.															
Nearest source of possible contamination: No potential source of contamination within 200 ft. ☐ Septic Tank ☐ Lateral Lines ☐ Pit Privy ☐ Livestock Pens ☐ Insecticide Storage ☐ Sewer Lines ☐ Cess Pool ☐ Sewage Lagoon ☐ Fuel Storage ☐ Abandoned Water Well ☐ Watertight Sewer Lines ☐ Seepage Pit ☐ Feedyard ☐ Fertilizer Storage ☐ Oil Well/Gas Well ☐ Other (Specify) Direction from well? Distance from well? ft.															
10 FROM	TO	LITHOLOGIC LOG	FROM	TO	LITHO. LOG (cont.) or PLUGGING INTERVALS										
			Notes:												
11 CONTRACTOR'S OR LANDOWNER'S CERTIFICATION: This water well was ☐ constructed, ☐ reconstructed, or ☐ plugged under my jurisdiction and was completed on (mo-day-year) and this record is true to the best of my knowledge and belief. Kansas Water Well Contractor's License No. This Water Well Record was completed on (mo-day-year) under the business name of															
Send one copy to WATER WELL OWNER and retain one for your records. Fee of \$5.00 for each <u>constructed</u> well. KS Department of Health and Environment, Bureau of Water, Geology Section, 1000 SW Jackson St., Suite 420, Topeka, Kansas 66612-1367. Telephone 785-296-3565. Visit us at http://www.kdheks.gov/waterwell/index.html KSA 82a-1212															

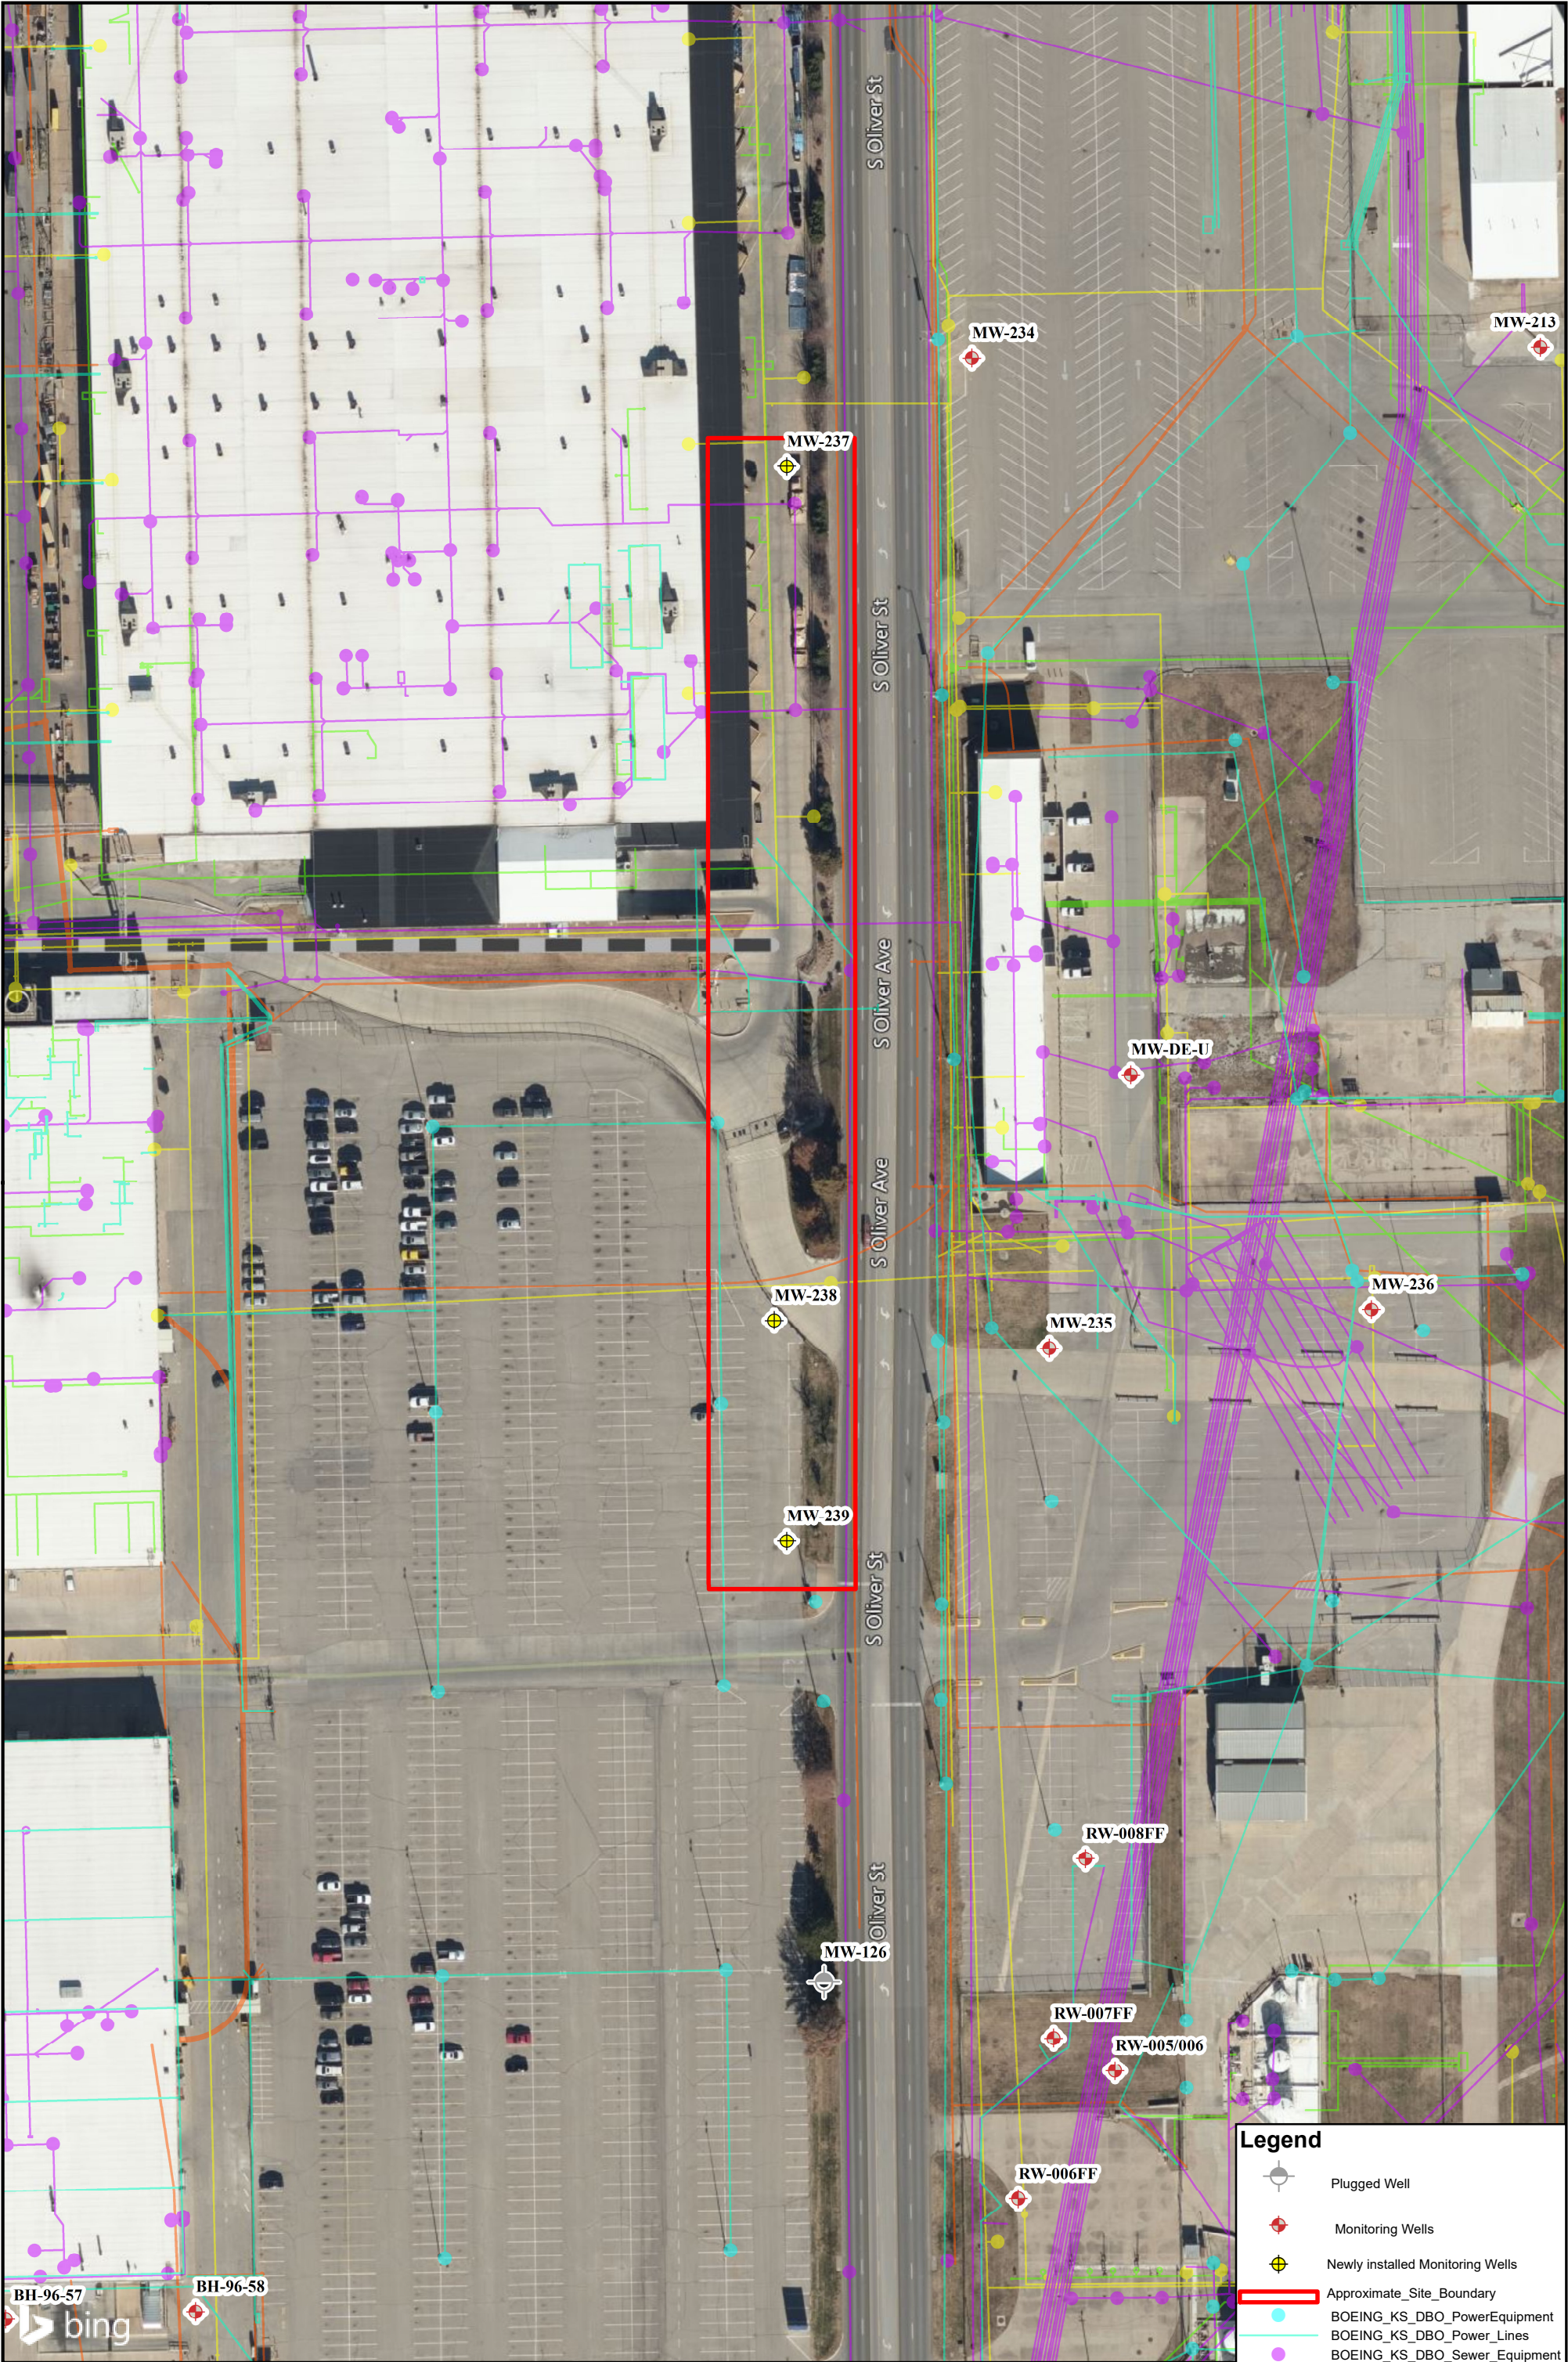


FIGURE: **2.0**
DATE: **06/22/2021**
DRAWN BY: **PM**

FIGURE NAME: **Oliver Well Location Map**
PROJECT NUMBER: **147550**
PROJECT MANAGER: **A. Chadd**

Spirit Aerosystems
3801 S. Oliver
Wichita, KS 67210

N
0 Feet 100
SCALE: 1" = 100'

- Legend**
- Plugged Well
 - Monitoring Wells
 - Newly installed Monitoring Wells
 - Approximate_Site_Boundary
 - BOEING_KS_DBO_PowerEquipment
 - BOEING_KS_DBO_Power_Lines
 - BOEING_KS_DBO_Sewer_Equipment
 - BOEING_KS_DBO_Sewer_Lines
 - BOEING_KS_DBO_Sewer_Structures
 - BOEING_KS_DBO_Water_Equip
 - BOEING_KS_DBO_Gas_Lines
 - BOEING_KS_DBO_Comm_Lines