

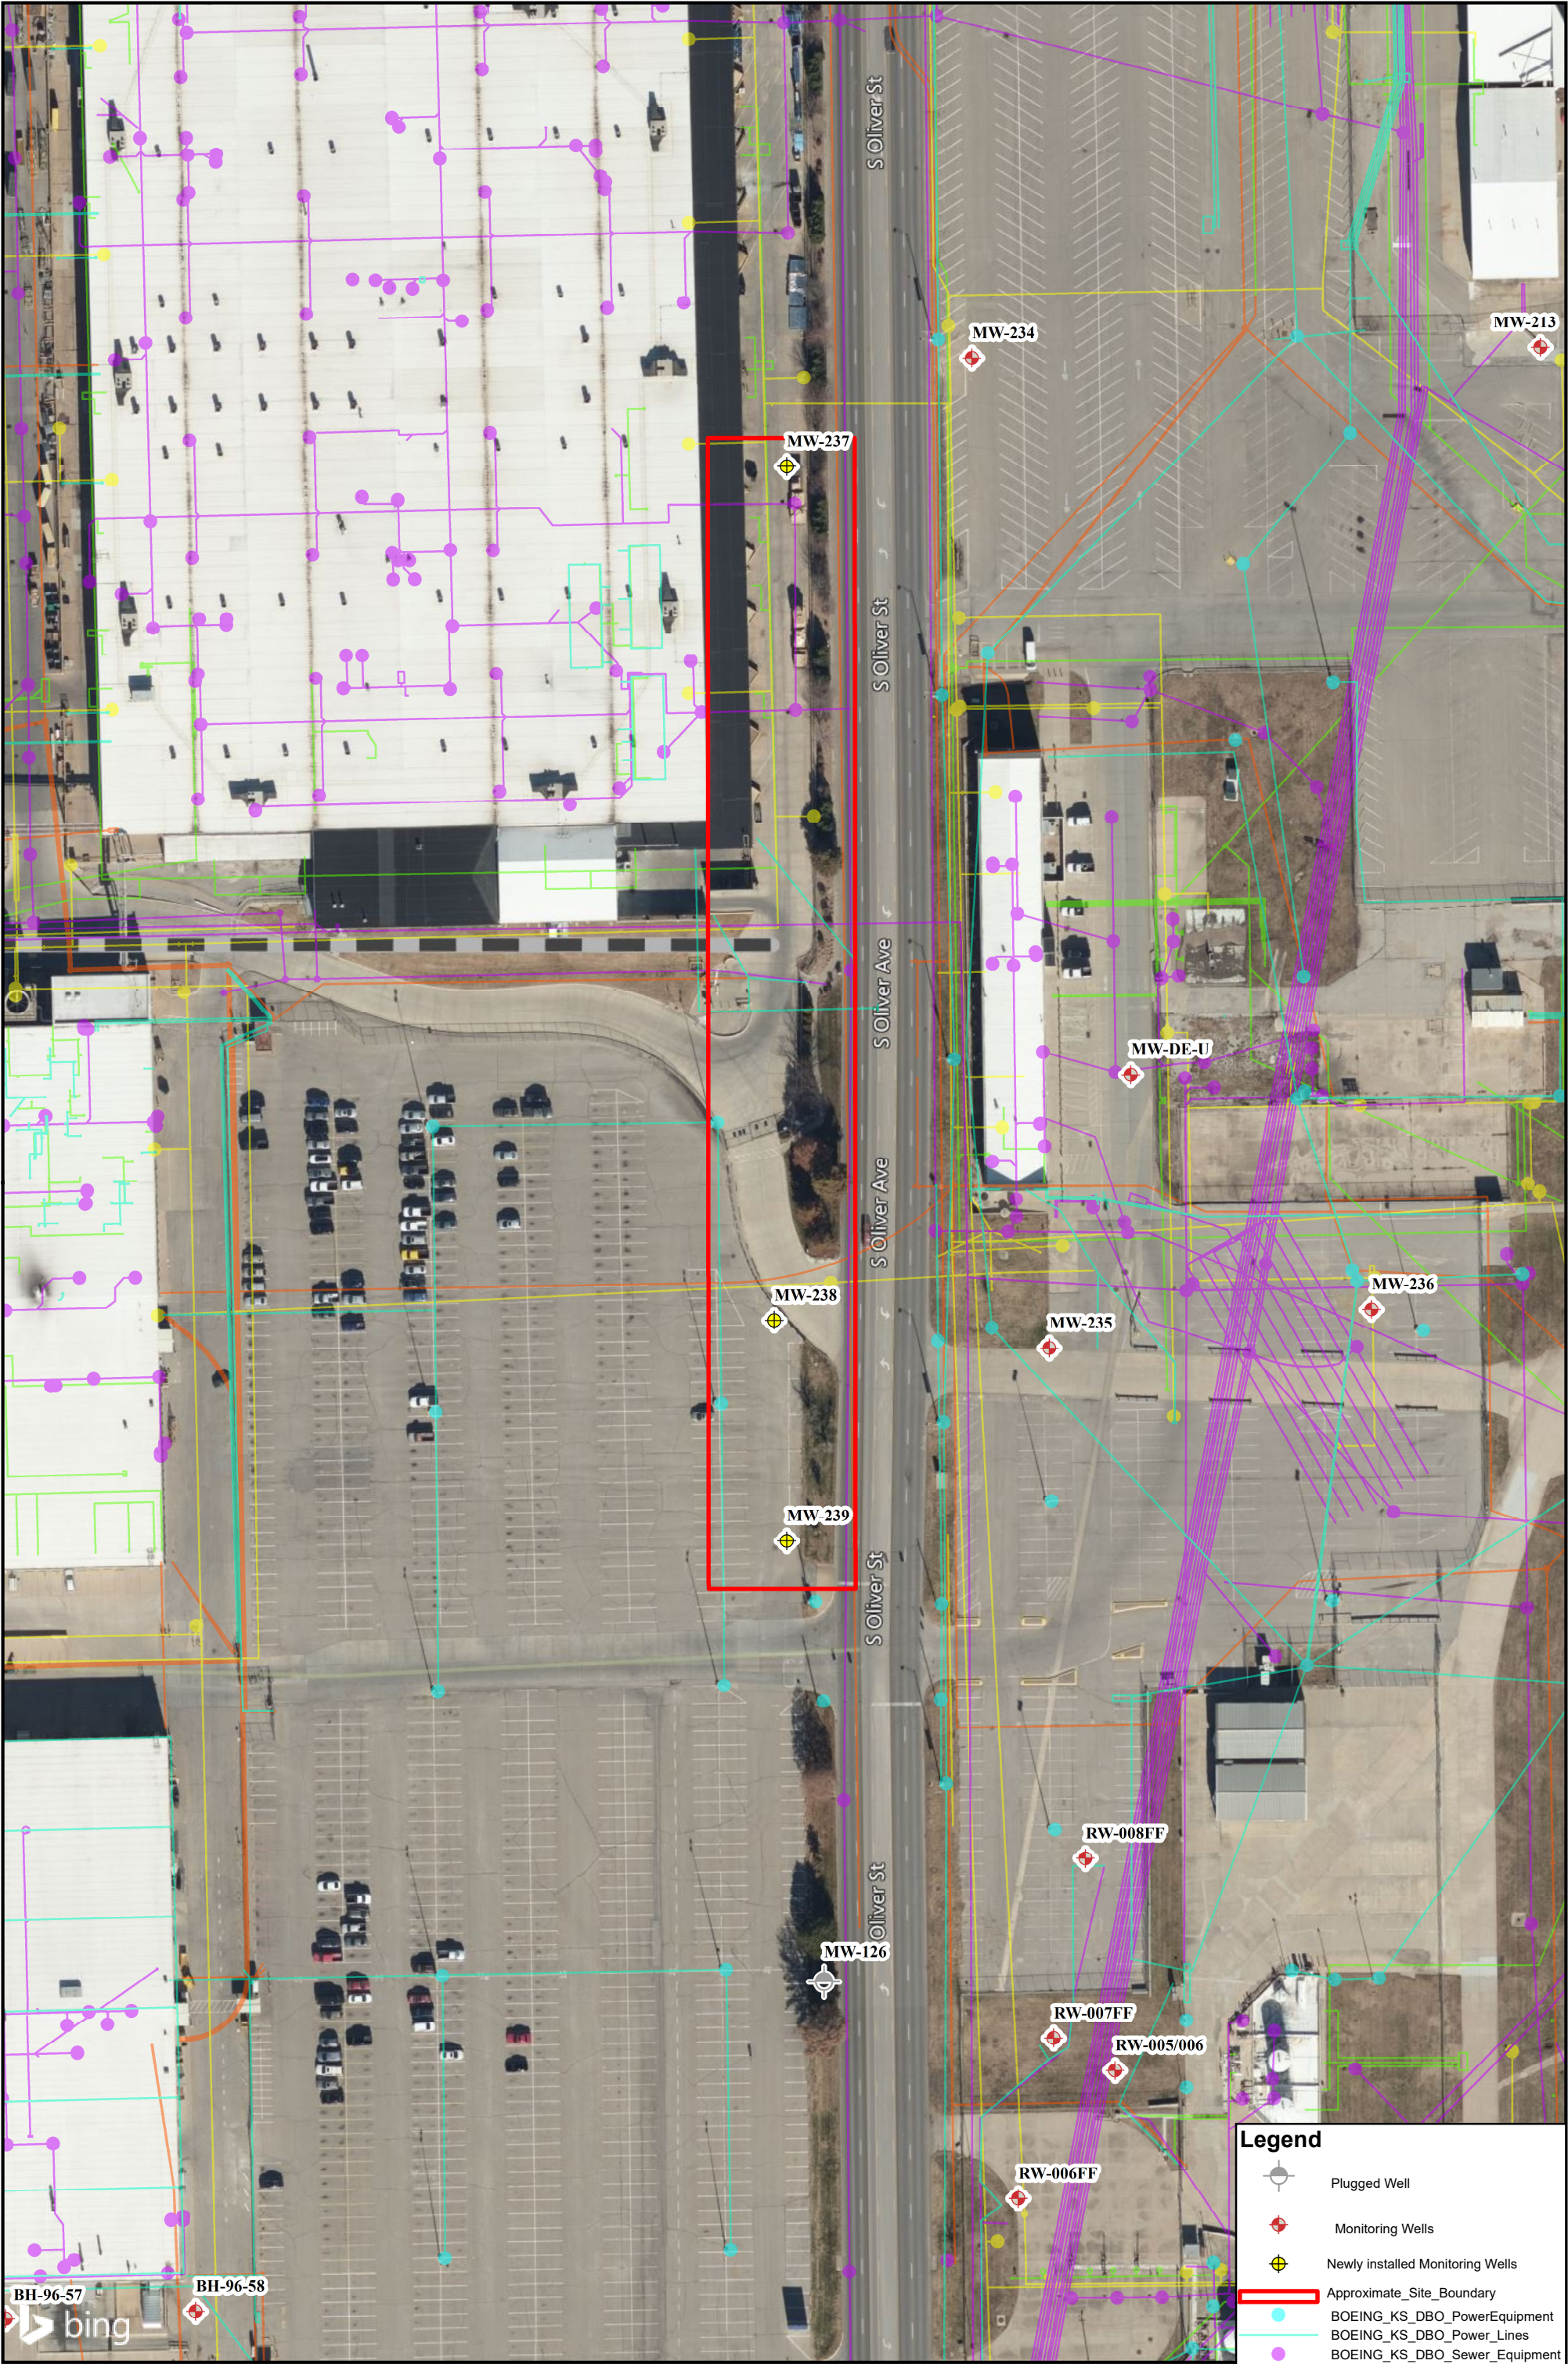


FIGURE: **2.0**
DATE: **06/22/2021**
DRAWN BY: **PM**

FIGURE NAME: **Oliver Well Location Map**
PROJECT NUMBER: **147550**
PROJECT MANAGER: **A. Chadd**

Spirit Aerosystems
3801 S. Oliver
Wichita, KS 67210

N
0 Feet 100
SCALE: 1" = 100'