

WATER WELL PLUGGING RECORD Form WWC-5P KSA 82a-1212 ID NO.

1 LOCATION OF WATER WELL: Fraction Section Number Township Number Range Number
 County: SEDGWICK SW ¼ SW ¼ SE ¼ SW ¼ 33 T 28 S 1 ☒ E ☐ W

Street/Rural Address of Well Location; if unknown, distance & direction from nearest town or intersection: If at owner's address, check here ☐ 701 E CHAPMAN ST HAYSVILLE, KS 67060


Global Positioning Systems (GPS) information:

Latitude: 37.565325 (in decimal degrees)
 Longitude: -97.328771 (in decimal degrees)
 Elevation:
 Horizontal Datum: ☒ WGS84, ☐ NAD83, ☐ NAD27
 Collection Method:

2 WATER WELL OWNER: APAC KANSAS
 RR#, St. Address, Box #: 3511 S WEST ST
 City, State ZIP Code: WICHITA, KS 67217

☒ GPS unit (Make/Model: I-PHONE)
☐ Digital Map/Photo, ☐ Topographic Map, ☐ Land Survey
 Est. Accuracy: ☐ < 3 m, ☐ 3-5 m, ☐ 5-15 m, ☐ > 15 m

3 MARK WELL'S LOCATION WITH AN "X" IN SECTION BOX:

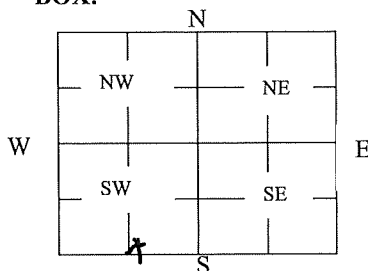

4 DEPTH OF WELL 25 ft.

WELL'S STATIC WATER LEVEL 14 ft

WELL WAS USED AS:

☐ Domestic ☐ Public Water Supply ☐ Dewatering
☐ Irrigation ☐ Oil Field Water Supply ☐ Monitoring
☐ Feedlot ☒ Domestic (Lawn & Garden) ☐ Injection Well
☐ Industrial ☐ Air Conditioning ☐ Other

Was a chemical/bacteriological sample submitted to Department? Yes ☐ No ☒

5 TYPE OF BLANK CASING USED:

☒ Steel ☐ RMP (SR) ☐ Wrought ☐ Fiberglass ☐ Other (Specify below)
☐ PVC ☐ ABS ☐ Asbestos-Cement ☐ Concrete Tile

Blank casing diameter 1 in. Was casing pulled? Yes ☐ No ☒ If yes, how much
 Casing height above or below land surface Below 36 in.

6 GROUT PLUG MATERIAL: ☐ Neat cement ☐ Cement grout ☒ Bentonite ☐ Other

Grout Plug Intervals: From 3 ft. to 25 ft., From ft. to ft., From ft. to ft.

What is the nearest source of possible contamination:

☐ Septic tank ☐ Seepage pit ☐ Fuel storage ☐ Other (specify below)
☐ Sewer lines ☐ Pit privy ☐ Fertilizer storage
☒ Watertight sewer lines ☐ Sewage lagoon ☐ Insecticide storage
☐ Lateral lines ☐ Feedyard ☐ Abandoned water well Direction from well? NORTH
☐ Cess pool ☐ Livestock pens ☐ Oil well/Gas well How many feet? 50+

FROM	TO	PLUGGING MATERIALS	FROM	TO	PLUGGING MATERIALS
0	3	COMPACTED TOP SOIL			
3	25	BENTONITE			

7 CONTRACTOR'S OR LANDOWNER'S CERTIFICATION: This water well was plugged under my jurisdiction and was completed on (mo/day/year) 11-19-2024 and this record is true to the best of my knowledge and belief. Kansas Water Well Contractor's License No. 236. This Water Well Record was completed on (mo/day/year) 11-19-2024 under the business name of HARP WELL & PUMP SERVICE, INC by (signature) TODD S. HARP

Send one white copy to Kansas Department of Health & Environment, Geology Section, 1000 SW Jackson Street, Ste. 420, Topeka, KS 66612-1367. Send one copy to WATER WELL OWNER and retain one for your records.
 Visit us at <http://www.kdheks.gov/waterwell/index.html> Telephone 785-296-5524.