USE TYPEWRITER OR BALL POINT PEN-PRESS FIRMLY, PRINT CLEARLY.

T R EW sec 1/4 1/4 1/4 No.

WATER WELL RECORD
KSA 82a-1201-1215

Kansas State Dept. Of Health
(Water Well Contractors)
Forbes-Bldg. 740
Topeko, Kansas 66620

NE SE SE NE

1 Location of well: County: Sedgwick | Township nome: Wichita | Fraction: NE 1/4 SE 1/4 SE 1/4 | Section number: 3 | Town number: T 28 S | Range number: R I E

Distance and direction from nearest town or city:

Street oddress of well location if in city: 3147 Range Rd.

3 Owner of well: Vernon F. Smith

Address: 3147 Range Rd.

Locate with "X" in section below:

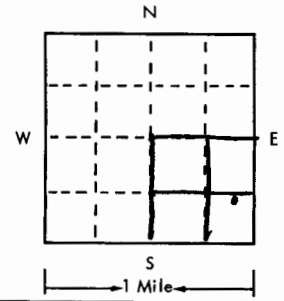

Sketch map:

NE 1/4 of the
SE 1/4 of the
NE 1/4 of

4 Well depth: 29 ft. Date of completion 9-11-75
Well diameter 6 in. Bore hole

5 ☐ Cable tool ☐ Rotary ☒ Driven ☐ Dug
☐ Hollow rod ☐ Jetted ☐ Bored ☐ Reverse rotary

6 Use: ☒ Domestic ☐ Public supply ☐ Industry
☐ Irrigation ☐ Air conditioning ☐ Commercial
☐ Test well ☐ _____

7 Casing: Material Steel Height: ☐ above ☒ below
Threaded ☒ Welded ☐ Surface 12 in.
Diam. _____ Weight _____ lbs./ft.
1 1/4 in. to 0 ft. depth Drive shoe? ☐ Yes ☐ No
1 1/4 in. to 29 ft. depth

2 Type and color of material	From	To
Dark Gray Clay	0	15
Lt. Tan Clay-Sand mix	15	20
Sand point unknown	20	29
(use a second sheet if needed)		

8 Screen:
Manufacturer Midwest
Type Sand Pt. Dia. 1 1/4
Slot/gauze 60 Length 4
Set between 25 ft. and 29 ft.
Fittings:
Gravel pack ☐ Yes ☒ No Size range of material ___

9 Static water level:
20 ft. below land surface Date 9-11-75

10 Pumping level below land surfaces:
21 ft. after 1/2 hrs. pumping ___ g.p.m.
7 ft. after ___ hrs. pumping ___ g.p.m.
Estimated maximum yield 900 g.p.m.

11 Water sample submitted:
☐ Yes ☒ No Date ___

12 Well head completion:
☐ Pitless adapter 12 ☒ Inches above grade

13 Well grouted? ☒ Yes ☐ No
☒ Neat cement ☐ Bentonite ☐ _____
Depth: From 0 ft. to 11 ft.

14 Nearest source of possible contamination:
ft. 15 Direction EAST Type CI Sewer
Well disinfected upon completion? ☐ Yes ☒ No

15 Pump: ☐ Not installed
Manufacturer's name F & W
Model number C835 HP 1/2 Volts 115
Length of drop pipe 29 ft. capacity 900 g.p.m.
Type:
☐ Submersible ☐ Turbine
☒ Jet ☐ Reciprocating
☐ Certrifugal ☐ Other

16 Remarks: elevation

Topography:
☐ Hill
☐ Slope
☐ Upland
☒ Valley

Lawn & Garden

17 Water well contractor's certification:
This well was drilled under my jurisdiction and this report is true to the best of my knowledge and belief.
Rotheroe Pump & Well 295
Business name 837 W. 27th So License No.
Address _____
Signed _____ Date 9-11-75
Authorized representative

Forward the white, blue and pink copies to the Kansas State Dept. Of Health.

Form WWC-5

677-H