


1 LOCATION OF WATER WELL: Fraction NE 1/4 SE 1/4 NE 1/4 Section Number 2 Township Number T 28 S Range Number R 1 **EAW**
 County: Sedgwick

Distance and direction from nearest town or city street address of well if located within city?
 400' SE of 2601 S. Oliver; Wichita, KS 50885119 MW-8

2 WATER WELL OWNER: Boeing Military Airplanes
 RR#, St. Address, Box #: P.O. Box 7730, M/S K06-00 Board of Agriculture, Division of Water Resources
 City, State, ZIP Code: Wichita, KS 67277-7730 Application Number:

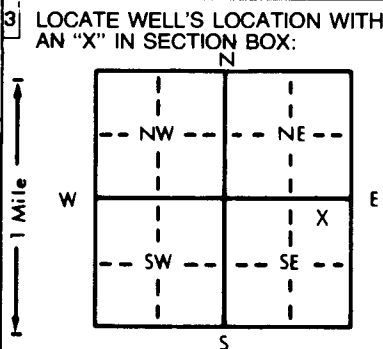

4 DEPTH OF COMPLETED WELL: 23.5 ft. ELEVATION: Approx. Surface Elevation: 1307.8
 Depth(s) Groundwater Encountered 1. None ft. 2. ft. 3. ft.
 WELL'S STATIC WATER LEVEL: 11.7 ft. below land surface measured on mo/day/yr 10/12/88
 Pump test data: Well water was ft. after hours pumping gpm
 Est. Yield N/A gpm: Well water was ft. after hours pumping gpm
 Bore Hole Diameter: 9 in. to 24 in. and in. to in.
 WELL WATER TO BE USED AS:
 5 Public water supply 8 Air conditioning 11 Injection well
 1 Domestic 3 Feedlot 6 Oil field water supply 9 Dewatering 12 Other (Specify below)
 2 Irrigation 4 Industrial 7 Lawn and garden only **10** Monitoring well
 Was a chemical/bacteriological sample submitted to Department? Yes.....No...X.....; If yes, mo/day/yr sample was submitted
 Water Well Disinfected? Yes No X

5 TYPE OF BLANK CASING USED:
 1 Steel 3 RMP (SR) 5 Wrought iron 8 Concrete tile CASING JOINTS: Glued Clamped
 2 PVC 4 ABS 6 Asbestos-Cement 9 Other (specify below) Welded
 7 Fiberglass Threaded
 Blank casing diameter in. to ft., Dia in. to ft., Dia in. to ft.
 Casing height above land surface in., weight lbs./ft. Wall thickness or gauge No.
 TYPE OF SCREEN OR PERFORATION MATERIAL:
 1 Steel 3 Stainless steel 5 Fiberglass 7 PVC 10 Asbestos-cement
 2 Brass 4 Galvanized steel 6 Concrete tile 8 RMP (SR) 11 Other (specify)
 12 None used (open hole)
 SCREEN OR PERFORATION OPENINGS ARE:
 1 Continuous slot 3 Mill slot 5 Gauzed wrapped 8 Saw cut 11 None (open hole)
 2 Louvered shutter 4 Key punched 6 Wire wrapped 9 Drilled holes
 7 Torch cut 10 Other (specify)
 SCREEN-PERFORATED INTERVALS: From ft. to ft., From ft. to ft., From ft. to ft.
 GRAVEL PACK INTERVALS: From ft. to ft., From ft. to ft., From ft. to ft.

6 GROUT MATERIAL: 1 Neat cement **2** Cement grout 3 Bentonite 4 Other
 Grout Intervals: From 0 ft. to 12 ft., From ft. to ft., From ft. to ft.
 What is the nearest source of possible contamination:
 1 Septic tank 4 Lateral lines 7 Pit privy **11** Fuel storage 14 Abandoned water well
 2 Sewer lines 5 Cess pool 8 Sewage lagoon 12 Fertilizer storage 15 Oil well/Gas well
 3 Watertight sewer lines 6 Seepage pit 9 Feedyard 13 Insecticide storage 16 Other (specify below)

Direction from well? Southeast How many feet? 100

FROM	TO	LITHOLOGIC LOG	FROM	TO	PLUGGING INTERVALS
0	1.5	Fill: Dark Brown Lean Clay With Sand			
1.5	6.5	Red-Brown Lean Clay			
6.5	15	Mottled Dark Brown to Gray-Brown Fat Clay			
15	23.5	Fat Clay With Calcareous Material			
23.5	24	Dark Gray Highly Weathered Shale			
THIS MONITORING WELL WAS PLUGGED ON 01/30/89 BY REMOVING CASING AND FILLING BOREHOLE WITH BENTONITE CEMENT GROUT FROM 0' TO 12'.					

7 CONTRACTOR'S OR LANDOWNER'S CERTIFICATION: This water well was (1) constructed, (2) reconstructed, or **(3)** plugged under my jurisdiction and was completed on (mo/day/year) 01/30/89 and this record is true to the best of my knowledge and belief. Kansas Water Well Contractor's License No. 416 This Water Well Record was completed on (mo/day/yr) 2-7-89 under the business name of Terracon Consultants Inc by (signature) [Signature]

INSTRUCTIONS: Use typewriter or ball point pen. PLEASE PRESS FIRMLY and PRINT clearly. Please fill in blanks, underline or circle the correct answers. Send top three copies to Kansas Department of Health and Environment, Bureau of Water Protection, Topeka, Kansas 66620-7320. Telephone: 913-296-5514. Send one to WATER WELL OWNER and retain one for your records.