USE TYPEWRITER OR BALL POINT PEN-PRESS FIRMLY, PRINT CLEARLY.

WATER WELL RECORD
KSA 82a-1201-1215

Kansas Department of Health and Environment-Division of Environment
(Water well Contractors)
Topeka, Kansas 66620

SW SW SW SE

1. Location of well:	County	Fraction	Section number	Township number	Range number
	Sedgwick	~~1/4~~ ~~1/4~~ C of SL DRP ~~1/4~~	3	T 28 S	R 1 E/W

2. Distance and direction from nearest town or city: Sewage Plant No. 1 City of Wichita
Street address of well location if in city: 3100 So. Grove

3. Owner of well: Centric Corporation
R.R. or street: Wichita, Kansas
City, state, zip code:

4. Locate with "X" in section below: Sketch map:

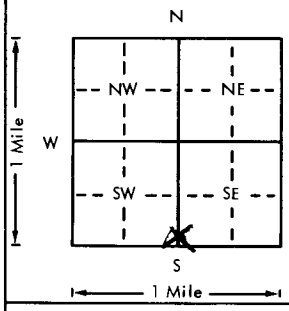

Well No. 5

6. Bore hole dia. 24 in. Completion date
Well depth 28 ft. 9/11/78

7. __ Cable tool __ Rotary __ Driven __ Dug
__ Hollow rod __ Jetted __ Bored X Reverse rotary

8. Use: __ Domestic __ Public supply __ Industry
__ Irrigation __ Air conditioning __ Stock
__ Lawn __ Oil field water __ X Other (dwater)

9. Casing: Material steel Height: Above ~~or below~~
Threaded ___ Welded X Surface 12 in.
RMP ___ PVC ___ Weight 31.25 lbs./ft.
Dia. 16 in. to 9 ft. depth Wall Thickness: inches or
Dia. ___ in. to ___ ft. depth gage No 188

10. Screen: Manufacturer's name Doerr
Type steel Dia. 16"
Slot/gauze 1/8 Length 20'
Set between 8 ft. and 28 ft.
___ ft. and ___ ft.
Gravel pack? yes Size range of material 1/8 x 1/2

5. Type and color of material	From	To
Fill dirt & rock	0	6
Silty fine sand	6	12
Med. to coarse sand & med. gravel	12	22
Blue clay & shale	22	25
Blue shale w/gypsum	25	28

(Use a second sheet if needed)

11. Static water level: mo./day/yr.
14 ft. below land surface Date 9/11/78

12. Pumping level below land surfaces: No test
___ ft. after ___ hrs. pumping ___ g.p.m.
___ ft. after ___ hrs. pumping ___ g.p.m.
Estimated maximum yield ___ g.p.m.

13. Water sample submitted: mo./day/yr.
___ Yes ✓ No Date

14. Well head completion:
___ Pitless adapter 12 Inches above grade

15. Well grouted? ✓
With: ___ Neat cement ✓ Bentonite ___ Concrete
Depth: From 0 ft. to 7 ft.

16. Nearest source of possible contamination: Sewage Plant
ft. 100' Direction South Type
Well disinfected upon completion? ___ Yes ✓ No

17. Pump: X Not installed
Manufacturer's name
Model number HP Volts
Length of drop pipe ft. capacity g.p.m.
Type:
___ Submersible ___ Turbine
___ Jet ___ Reciprocating
___ Centrifugal ___ Other

18. Elevation:

Topography:
___ Hill
___ Slope
___ Upland
X Valley

19. Remarks: Well to be salvaged upon completion of Dewatering for new pump Station

20. Water well contractor's certification:
This well was drilled under my jurisdiction and this report is true to the best of my knowledge and belief.
Layne Western Co. 102
Business name License No.
Address Wichita Kansas
Signed Authorized representative Date 10/9/78

T 28 — R 1 E — Sec 3 — 1/4 C 1/4 S 1/2 1/4

Forward the white, blue and pink copies to the Department of Health and Environment

Form WWC-5

MI-1023