

1 LOCATION OF WATER WELL: County: <u>Sedgwick</u>	Fraction <u>SW</u> $\frac{1}{4}$ <u>NE</u> $\frac{1}{4}$ <u>NE</u> $\frac{1}{4}$	Section Number <u>3</u>	Township Number T <u>28</u> S	Range Number R <u>1</u> <u>EW</u>
--	---	----------------------------	----------------------------------	--------------------------------------

Distance and direction from nearest town or city street address of well if located within city?


SAME AS Below

2 WATER WELL OWNER: WAYNE B. OWELL
RR#, St. Address, Box #: 2053 EL RANCHO
City, State, ZIP Code: WILSON, ED. 67214

Board of Agriculture, Division of Water Resources
Application Number: _____

3 LOCATE WELL'S LOCATION WITH AN "X" IN SECTION BOX:

4 DEPTH OF COMPLETED WELL. 26 ft. ELEVATION: 1297

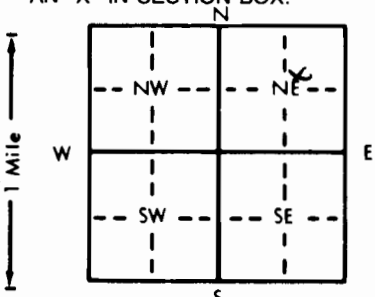

Depth(s) Groundwater Encountered 1. 12 ft. 2. _____ ft. 3. _____ ft.

WELL'S STATIC WATER LEVEL 12 ft. below land surface measured on mo/day/yr _____

Pump test data: Well water was _____ ft. after _____ hours pumping _____ gpm

Est. Yield 15.5 gpm: Well water was _____ ft. after _____ hours pumping _____ gpm

Bore Hole Diameter 9 in. to 26 ft., and _____ in. to _____ ft.

WELL WATER TO BE USED AS:

1 Domestic	3 Feedlot	6 Oil field water supply	9 Dewatering	11 Injection well
2 Irrigation	4 Industrial	7 Lawn and garden only	10 Monitoring well	12 Other (Specify below)

Was a chemical/bacteriological sample submitted to Department? Yes _____ No ✓ If yes, mo/day/yr sample was submitted _____

Water Well Disinfected? Yes _____ No ✓

5 TYPE OF BLANK CASING USED:

5 Wrought iron	8 Concrete tile	CASING JOINTS: Glued ☒ Clamped ☐
6 Asbestos-Cement	9 Other (specify below)	Welded ☐
7 Fiberglass		Threaded ☐

Blank casing diameter 5 in. to 20 ft. Dia. in. to ft. Dia. in. to ft.
Casing height above land surface 12 in. weight 2.3 lbs./ft. Wall thickness or gauge No. SD 26

TYPE OF SCREEN OR PERFORATION MATERIAL:

1 Steel	3 Stainless steel	5 Fiberglass	8 RMP (SR)	11 Other (specify)
2 Brass	4 Galvanized steel	6 Concrete tile	9 ABS	12 None used (open hole)

SCREEN OR PERFORATION OPENINGS ARE:

1 Continuous slot 3 Mill slot 6 Wire wrapped 9 Drilled holes
2 Louvered shutter 4 Key punched 7 Torch cut 10 Other (specify)

SCREEN-PERFORATED INTERVALS: From 20 ft. to 26 ft., From _____ ft. to _____ ft.

	From.....	ft. to	ft., From	ft. to.....	ft.
GRAVEL PACK INTERVALS:	From.....	ft. to	ft., From	ft. to.....	ft.
	From	ft. to	ft., From	ft. to	ft.

6 GROUT MATERIAL: 1 Neat cement 2 Cement grout 3 Bentonite 4 Other

Grout Intervals: From 0 ft. to 12 ft. From _____ ft. to _____ ft. From _____ ft. to _____ ft.

What is the nearest source of possible contamination: NONE 10 Livestock pens 14 Abandoned water well

1 Septic tank	4 Lateral lines	7 Pit privy	11 Fuel storage	15 Oil well/Gas well
2 Sewer lines	5 Cess pool	8 Sewage lagoon	12 Fertilizer storage	16 Other (specify below)
3 Watertight sewer lines	6 Seepage pit	9 Feedyard	13 Insecticide storage	<i>N/A</i>

Direction from well?

How many feet?

[illegible]

7 CONTRACTOR'S OR LANDOWNER'S CERTIFICATION: This water well was (1) constructed, (2) reconstructed, or (3) plugged under my jurisdiction and was completed on (mo/day/year) 3-1-88 and this record is true to the best of my knowledge and belief. Kansas Water Well Contractor's License No. 463 This Water Well Record was completed on (mo/day/yr) 6-1-88 under the business name of RJA by (signature) Dave RJA