


1 LOCATION OF WATER WELL:	Fraction	Section Number	Township Number	Range Number
County: Sedgwick	NE ¼ NE ¼ NE ¼	4	T 28 S	R 1 EAW

Distance and direction from nearest town or city street address of well if located within city?
1535 E. Pawnee; Wichita, KS 40865090 MW-27

2 WATER WELL OWNER: FINA Oil and Chemical Company		Board of Agriculture, Division of Water Resources Application Number:
RR#, St. Address, Box # : 8350 N. Central Expressway		
City, State, ZIP Code :		

3	LOCATE WELL'S LOCATION WITH AN "X" IN SECTION BOX:	4	DEPTH OF COMPLETED WELL..... 19.5	ft. ELEVATION: Approx. Ground Surface 1284
---	--	---	-----------------------------------	--

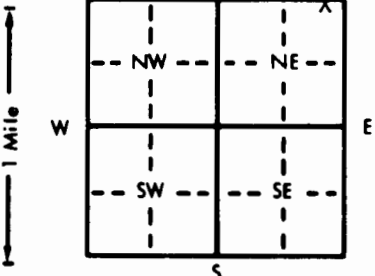

4 DEPTH OF COMPLETED WELL..... 19.5 ft. ELEVATION: Approx. Ground Surface 1284

WELL'S STATIC WATER LEVEL 13.7 ft below land surface measured on mo/day/yr 7/16/87

Pump test data: Well water was ft. after hours pumping gpm

Est. Yield	N/A	gpm:	Well water was	ft. after	hours pumping	gpm
Produced Water	6.5		19.5			

WELL WATER TO BE USED AS: 5 Public water supply 8 Air conditioning 11 Injection well

1 Domestic	3 Feedlot	6 Oil field water supply	9 Dewatering	12 Other (Specify below)
------------	-----------	--------------------------	--------------	--------------------------

2 Irrigation 4 Industrial 7 Lawn and garden only 10 Observation well

Was a chemical/bacteriological sample submitted to Department? Yes.....No.....^.....; If yes, mo/day/yr sample was submitted
Water Well Disinfected? Yes No X

5	TYPE OF BLANK CASING USED:	5 Wrought iron	8 Concrete tile	CASING JOINTS: Glued Clamped
---	----------------------------	----------------	-----------------	--

1 Steel	3 RMP (SRI)	6 Asbestos-Cement	9 Other (specify below)	Welded
② PVC	4 ABS	7 Fiberglass		Threaded

Blank casing diameter . . . 2 . . . in. to . . . 9.5 . . . ft., Dia . . . in. to . . . ft., Dia . . . in. to . . . ft.

Casing height above land surface in., weight lbs./ft. Wall thickness or gauge No.

TYPE OF SCREEN OR PERFORATION MATERIAL: (7) PVC 10 Asbestos-cement

1 Steel 3 Stainless steel 5 Fiberglass 8 RMP (SR) 11 Other (specify)

2 Brass 4 Galvanized steel 6 Concrete tile 9 ABS 12 None used (open hole)

SCREEN OR PERFORATION OPENINGS ARE:

1 Continuous slot	3 Mill slot	5 Gauzed wrapped	8 Saw cut	11 None (open hole)
		6 Wire wrapped	9 Drilled holes	

2 Louvered shutter 4 Key punched 7 Torch cut 10 Other (specify)

SCREEN-PERFORATED INTERVALS: From 9.5 ft. to 19.5 ft., From . ft. to . ft.

GRAVE PACK INTERVALS: From 7 ft to 19.5 ft From ft to ft

From	ft. to	ft., From	ft. to	ft.
------	--------	-----------	--------	-----

6] GROUT MATERIAL: 1 Neat cement 2 Cement grout 3 Bentonite 4 Other

Grout intervals: From 0 ft. to 1.5 ft., From 1.5 ft. to 7 ft., From _____ ft. to _____ ft.

What is the nearest source of possible contamination: 10 Livestock pens 14 Abandoned water well

1 Septic tank 4 Lateral lines 7 Pit privy 11 Fuel storage 15 Oil well/Gas well

2 Sewer lines	5 Cess pool	8 Sewage lagoon	12 Fertilizer storage	16 Other (specify below)
---------------	-------------	-----------------	-----------------------	--------------------------

3 Watertight sewer lines 6 Seepage pit 9 Feedyard 13 Insecticide storage
Direction from well? Northwest How many feet? 125

FROM		TO		LITHOLOGIC LOG	

[illegible]

7 CONTRACTOR'S OR LANDOWNER'S CERTIFICATION: This water well was (1) constructed, (2) reconstructed, or (3) plugged under my jurisdiction and was completed on (mo/day/year) 7/13/87 and this record is true to the best of my knowledge and belief. Kansas

Water Well Contractor's License No. 410 This Water Well Record was completed on (mo/day/yr) 10/20/11
under the business name of Terracon Consultants, INC by (signature) [Signature]

INSTRUCTIONS: Use typewriter or ball point pen. PLEASE PRESS FIRMLY and PRINT clearly. Please fill in blanks, underline or circle the correct answers. Send top three copies to Kansas Department of Health and Environment, Office of Oil Field and Environmental Geology, Regulation and Permitting Section, Topeka, Kansas 66620-7500, Telephone: 913-862-9360. Send one to WATER WELL OWNER and retain one for your records.