

SE NW SW NE

WATER WELL RECORD

Form WWC-5

KSA 82a-1212

1 LOCATION OF WATER WELL:	Fraction	Section Number	Township Number	Range Number
County: SEOWICK	NW 1/4 S24 1/4 SE 1/4	9	T 28 S	R 1 EN


Distance and direction from nearest town or city street address of well if located within city?

SAME AS Below

2 WATER WELL OWNER:	Board of Agriculture, Division of Water Resources
RR#, St. Address, Box # :	Application Number:
City, State, ZIP Code :	

TUNY BOVE**1210 PICTUNA****Wich. KS. 67217**

3 LOCATE WELL'S LOCATION WITH AN "X" IN SECTION BOX:	4 DEPTH OF COMPLETED WELL	ELEVATION:
--	---------------------------	------------

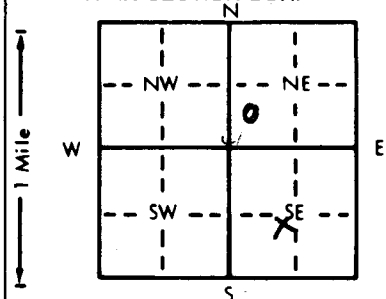

DEPTH OF COMPLETED WELL	30	ft.	ELEVATION:	1278	ft.
Depth(s) Groundwater Encountered	1. 12	ft.	2.		ft.
WELL'S STATIC WATER LEVEL	12	ft.	below land surface measured on mo/day/yr		
Pump test data:	Well water was		ft. after		hours pumping
Est. Yield	25+	gpm	Well water was		ft. after
Bore Hole Diameter	2	in.	to	5	ft., and
WELL WATER TO BE USED AS:	5 Public water supply	8 Air conditioning	11 Injection well		
1 Domestic	3 Feedlot	6 Oil field water supply	9 Dewatering	12 Other (Specify below)	
2 Irrigation	4 Industrial	7 Lawn and garden only	10 Observation well		
Was a chemical/bacteriological sample submitted to Department?	Yes	No	X		
Water Well Disinfected?	Yes	X	No		

5 TYPE OF BLANK CASING USED:	5 Wrought iron	8 Concrete tile	CASING JOINTS: Glued	Clamped
1 Steel	3 RMP (SR)	6 Asbestos-Cement	9 Other (specify below)	Welded
2 PVC	4 ABS	7 Fiberglass		Threaded
Blank casing diameter	1.44	in.	to	ft., Dia
Casing height above land surface	12	in.	weight	lbs./ft. Wall thickness or gauge No.

TYPE OF SCREEN OR PERFORATION MATERIAL:	7 PVC	10 Asbestos-cement
1 Steel	3 Stainless steel	5 Fiberglass
2 Brass	4 Galvanized steel	6 Concrete tile
SCREEN OR PERFORATION OPENINGS ARE:	5 Gauzed wrapped	8 Saw cut
1 Continuous slot	3 Mill slot	6 Wire wrapped
2 Louvered shutter	4 Key punched	7 Torch cut

SCREEN-PERFORATED INTERVALS:	From	30	ft.	to	27	ft.
GRAVEL PACK INTERVALS:	From		ft.	to		ft.

6 GROUT MATERIAL:	1 Neat cement	2 Cement grout	3 Bentonite	4 Other		
Grout Intervals:	From		ft.	to		ft.
What is the nearest source of possible contamination:	NONE NOTED					
1 Septic tank	4 Lateral lines	7 Pit privy	10 Livestock pens	14 Abandoned water well		
2 Sewer lines	5 Cess pool	8 Sewage lagoon	11 Fuel storage	15 Oil well/Gas well		
3 Watertight sewer lines	6 Seepage pit	9 Feedyard	12 Fertilizer storage	16 Other (specify below)		

Direction from well?	How many feet?
----------------------	----------------

FROM	TO	LITHOLOGIC LOG	FROM	TO	LITHOLOGIC LOG
0	4	SANDY LOAM			
4	30	SAND			

7 CONTRACTOR'S OR LANDOWNER'S CERTIFICATION:	This water well was	(1) constructed, (2) reconstructed, or (3) plugged under my jurisdiction and was completed on (mo/day/year)	7-12-87	and this record is true to the best of my knowledge and belief.	Kansas
Water Well Contractor's License No.	463	This Water Well Record was completed on (mo/day/yr)	6-1-88		
under the business name of	REA WATER WELL	by (signature)	Daniel Richey		

INSTRUCTIONS: Use typewriter or ball point pen, PLEASE PRESS FIRMLY and PRINT clearly. Please fill in blanks, underline or circle the correct answers. Send top three copies to Kansas Department of Health and Environment, Division of Environment, Environmental Geology Section, Topeka, KS 66620. Send one to WATER WELL OWNER and retain one for your records.