


1 LOCATION OF WATER WELL: **Sedgwick** FRACTION **NE NE SE NW** Section Number **5** Township Number **T 28 S** Range Number **R 1E E/W**

Distance and direction from nearest town or city street address of well if located within city?

2640 Exchange Wichita, Kansas

2 WATER WELL OWNER: **KEMP, Jim** Board of Agriculture, Division of Water Resource
 RR#, ST. ADDRESS, BOX #: **2640 Exchange**
 CITY, STATE, ZIP CODE: **Wichita, Kansas** Application Number:

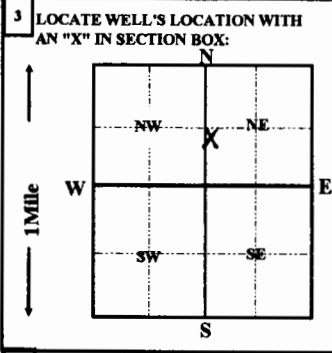

4 DEPTH OF COMPLETED WELL **40** ft. ELEVATION:
 Depth(s) groundwater Encountered **1** ft. **2** ft. **3** ft.
 WELL'S STATIC WATER LEVEL **15** FT. BELOW LAND SURFACE MEASURED ON **06/23/1992**
 Pump test data: Well water was _____ ft. after _____ hours pumping _____ gpm
 Est. Yield gpm: Well water was _____ ft. after _____ hours pumping _____ gpm
 Bore Hole Diameter **12** in. to **40** ft., and _____ in. to _____ ft.
 WELL WATER TO BE USED AS: **5** Public water supply **8** Air conditioning **11** Injection well
1 Domestic **3** Feedlot **6** Oil field water supply **9** dewatering **12** Other (Specify below)
2 Irrigation **4** Industrial **7** Lawn and garden only **10** Monitoring well
 Was a chemical/bacteriological sample submitted to Department? Yes _____ No **X**; If yes, mo/day/yr sample was submitted _____
 Water Well Disinfected? Yes **X** No _____

5 TYPE OF CASING USED:
 1 Steel 3 RMP (SR) 5 Wrought iron 8 Concrete tile CASING JOINTS: Glued **X** Clamped
 2 PVC 4 ABS 6 Asbestos-Cement 9 Other (Specify below) Welded
 7 Fiberglass **SDR-26** Threaded
 Blank casing Diameter **5** in. to **25** ft., Dia _____ in. to _____ ft.
 Casing height above land surface **12** in., weight **2.29** lbs./ft. Wall thickness or gauge No. **.214**
 TYPE OF SCREEN OR PERFORATION MATERIAL:
 1 Steel 3 Stainless Steel 5 Fiberglass 8 RMP (SR) 11 other (specify)
 2 Brass 4 Galvanized steel 6 Concrete tile 9 ABS 12 None used (open hole)
 SCREEN OR PERFORATION OPENING ARE:
 1 Continuous slot 3 Mill slot 5 Gauzed wrapped 8 Saw cut 11 None (open hole)
 2 Louvered shutter 4 Key punched 6 Wire wrapped 9 Drilled holes
 7 Torch cut 10 Other (specify)
 SCREEN-PERFORATION INTERVALS: from **25** ft. to **40** ft., From _____ ft. to _____ ft.
 GRAVEL PACK INTERVALS: from **24** ft. to **40** ft., From _____ ft. to _____ ft.

6 GROUT MATERIAL: 1 Neat cement 2 Cement grout 3 Bentonite 4 Other
 Grout Intervals: From **4** ft. to **24** ft., From _____ ft. to _____ ft.
 What is the nearest source of possible contamination:
 1 Septic tank 4 Lateral lines 7 Pit privy 10 Livestock pens 14 Abandon water well
 2 Sewer lines 5 Cess pool 8 Sewage lagoon 11 Fuel storage 15 Oil well/Gas well
 3 Watertight sewer lines 6 Seepage pit 9 Feedyard 12 Fertilizer storage 16 Other (specify below)
 13 Insecticide storage
 Direction from well? **West** How many feet? **30**

FROM	TO	LITHOLOGIC LOG	FROM	TO	PLUGGING INTERVALS
0	3	topsoil			
3	7	clay (sandy)			
7	18	fine sand			
18	40	medium sand			

7 CONTRACTOR'S OR LANDOWNER'S CERTIFICATION: This water well was (1) constructed, (2) reconstructed, or (3) plugged under my jurisdiction and was completed on (mo/day/year) **06/23/1992** and this record is true to the best of my knowledge and belief. Kansas Water Well Contractor's License No. **236** This Water Well Record was completed on (mo/day/yr) **8.28.92**
 Under the business name of **Harp Well & Pump Service, Inc.** by (signature) *Jane Frederick*