

NW SE NW NW

WATER WELL RECORD

Form WWC-5

KSA 82a-1212

Plugging Report

OFFICE USE ONLY

H

EW

SEC.

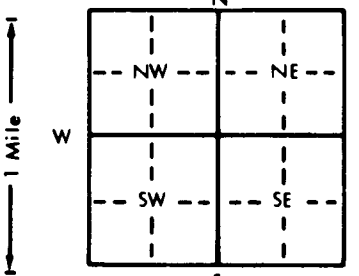
1/4

1/4

1/4

1/4

1/4

1 LOCATION OF WATER WELL:		Fraction	Section Number	Township Number	Range Number
County: Sedgwick		NE 1/4	6	T 28 S	R 1 E
Distance and direction from nearest town or city street address of well if located within city?					
2222 SAVANNAH Wichita KS 67217					
2 WATER WELL OWNER: J KINKAD					
RR#, St. Address, Box #: 2222 SAVANNAH					
City, State, ZIP Code: WICHITA KS 67217					
Board of Agriculture, Division of Water Resources					
Application Number:					
3 LOCATE WELL'S LOCATION WITH AN "X" IN SECTION BOX:		4 DEPTH OF COMPLETED WELL: 30 ft. ELEVATION:			
		Depth(s) Groundwater Encountered 1. ft. 2. ft. 3. ft.			
		WELL'S STATIC WATER LEVEL 15 ft. below land surface measured on mo/day/yr 10-8-92			
		Pump test data: Well water was ft. after hours pumping gpm			
		Est. Yield gpm: Well water was ft. after hours pumping gpm			
		Bore Hole Diameter .in. to .ft., and .in. to .ft.			
		WELL WATER TO BE USED AS:			
		1 Domestic WAS 3 Feedlot 6 Oil field water supply 9 Dewatering 12 Other (Specify below)			
		2 Irrigation 4 Industrial 7 Lawn and garden only 10 Monitoring well			
		Was a chemical/bacteriological sample submitted to Department? Yes.....No.....; If yes, mo/day/yr sample was submitted			
		Water Well Disinfected? Yes No			
5 TYPE OF BLANK CASING USED:					
1 Steel 3 RMP (SR) 5 Wrought iron 8 Concrete tile CASING JOINTS: Glued Clamped					
2 PVC 4 ABS 6 Asbestos-Cement 9 Other (specify below) Welded					
7 Fiberglass Threaded					
Blank casing diameter .in. to .ft., Dia .in. to .ft., Dia .in. to .ft.					
Casing height above land surface 3 ft. below in., weight lbs./ft. Wall thickness or gauge No.					
TYPE OF SCREEN OR PERFORATION MATERIAL:					
1 Steel 3 Stainless steel 5 Fiberglass 7 PVC 10 Asbestos-cement					
2 Brass 4 Galvanized steel 6 Concrete tile 8 RMP (SR) 11 Other (specify) NA					
12 None used (open hole)					
SCREEN OR PERFORATION OPENINGS ARE:					
1 Continuous slot 3 Mill slot 5 Gauzed wrapped 8 Saw cut 11 None (open hole)					
2 Louvered shutter 4 Key punched 6 Wire wrapped 9 Drilled holes					
7 Torch cut 10 Other (specify) NA					
SCREEN-PERFORATED INTERVALS: From NA ft. to NA ft., From ft. to ft.					
From ft. to ft., From ft. to ft.					
GRAVEL PACK INTERVALS: From ft. to ft., From ft. to ft.					
From ft. to ft., From ft. to ft.					
6 GROUT MATERIAL: Neat cement 2 Cement grout 3 Bentonite 4 Other					
Grout Intervals: From 15 ft. to 3 ft., From ft. to ft., From ft. to ft.					
What is the nearest source of possible contamination:					
1 Septic tank 4 Lateral lines 7 Pit privy 10 Livestock pens 14 Abandoned water well					
2 Sewer lines 5 Cess pool 8 Sewage lagoon 11 Fuel storage 15 Oil well/Gas well					
3 Watertight sewer lines 6 Seepage pit 9 Feedyard 12 Fertilizer storage 16 Other (specify below)					
13 Insecticide storage					
Direction from well? South					
How many feet? one					
FROM TO LITHOLOGIC LOG FROM TO PLUGGING INTERVALS					
30 15 clean sand 35 ft 3					
15 3 neat cement 28 ft 3					
3 0 back fill					
30 15 clean sand 3 ft 3					
15 3 neat cement 2.4 ft 3					
3 0 back fill					
7 CONTRACTOR'S OR LANDOWNER'S CERTIFICATION: This water well was (1) constructed, (2) reconstructed, or (3) plugged under my jurisdiction and was completed on (mo/day/year) 10-9-92 and this record is true to the best of my knowledge and belief. Kansas Water Well Contractor's License No. This Water Well Record was completed on (mo/day/yr) 10-12-97 under the business name of by (signature)					
INSTRUCTIONS: Use typewriter or ball point pen. PLEASE PRESS FIRMLY and PRINT clearly. Please fill in blanks, underline or circle the correct answers. Send top three copies to Kansas Department of Health and Environment, Bureau of Water, Topeka, Kansas 66620-0001. Telephone: 913-296-5545. Send one to WATER WELL OWNER and retain one for your records.					