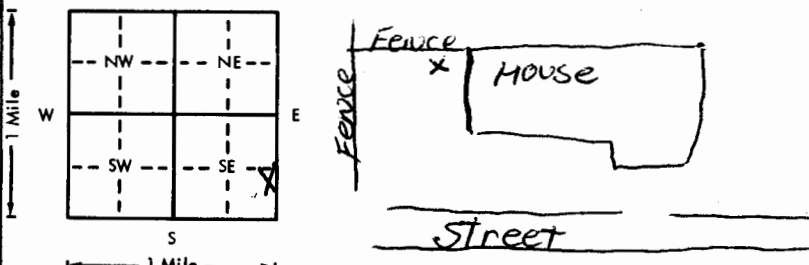


USE TYPEWRITER OR BALL
POINT PEN—PRESS FIRMLY,
PRINT CLEARLY.

WATER WELL RECORD
KSA 82a-1201-1215

Kansas Department of Health and
Environment—Division of Environment
(Water well Contractors)
Topeka, Kansas 66620

1. Location of well:		County <u>Sedgewick</u>	Fraction <u>NE 1/4 SE 1/4 SE 1/4</u>	Section number <u>6</u>	Township number <u>T 28 S</u>	Range number <u>R 1 E E/W</u>
2. Distance and direction from nearest town or city: Street address of well location if in city:		<u>IN CITY of WICHITA</u> <u>1403 MARLBORO</u>		3. Owner of well: <u>HOWARD SMITH</u> R.R. or street: <u>1403 MARLBORO</u> City, state, zip code: <u>WICHITA, KANSAS</u>		
4. Locate with "X" in section below:		Sketch map:		6. Bore hole dia. <u>11</u> in. Completion date <u>7-5-77</u> Well depth <u>30</u> ft.		
				7. ☐ Cable tool ☒ Rotary ☐ Driven ☐ Dug ☐ Hollow rod ☐ Jetted ☐ Bored ☐ Reverse rotary		
5. Type and color of material				8. Use: ☐ Domestic ☐ Public supply ☐ Industry ☐ Irrigation ☐ Air conditioning ☐ Stock ☒ Lawn ☐ Oil field water ☐ Other		
				9. Casing: Material <u>Steel</u> Height: Above or below Threaded ☐ Welded ☒ Surface <u>12</u> in. RMP ☐ PVC ☐ Weight <u>16</u> lbs./ft. Dia. <u>5 1/2</u> in. to <u>30</u> ft. depth Wall Thickness: inches or Dia. <u>5</u> in. to <u>30</u> ft. depth gage No. <u>200</u>		
				10. Screen: Manufacturer's name <u>814</u> Type <u>200</u> Dia. <u>5"</u> Slot/gauze <u>065</u> Length <u>10'</u> Set between <u>20</u> ft. and <u>30</u> ft. ft. and <u>30</u> ft. Gravel pack? <u>YES</u> Size range of material <u>3/8"-3/4"</u>		
				11. Static water level: <u>15</u> ft. below land surface Date <u>7-5-77</u>		
				12. Pumping level below land surfaces: <u>15</u> ft. after <u>2</u> hrs. pumping <u>15</u> g.p.m. <u>15</u> ft. after <u>2</u> hrs. pumping <u>15</u> g.p.m. Estimated maximum yield <u>50</u> g.p.m.		
				13. Water sample submitted: <u>Yes</u> ☒ No ☐ Date <u>7-5-77</u>		
				14. Well head completion: ☐ Pitless adapter <u>12</u> inches above grade		
				15. Well grouted? <u>YES</u> With: ☐ Neat cement ☒ Bentonite ☐ Concrete Depth: From <u>0</u> ft. to <u>10</u> ft.		
				16. Nearest source of possible contamination: ft. <u>50</u> Direction <u>EAST</u> Type <u>SEWER</u> Well disinfected upon completion? <u>Yes</u> ☒ <u>No</u> ☐		
				17. Pump: ☒ Not installed Manufacturer's name _____ Model number _____ HP _____ Volts _____ Length of drop pipe _____ ft. capacity _____ g.p.m. Type: ☐ Submersible ☐ Turbine ☐ Jet ☐ Reciprocating ☐ Centrifugal ☐ Other		
18. Elevation:		19. Remarks:		20. Water well contractor's certification: This well was drilled under my jurisdiction and this report is true to the best of my knowledge and belief. <u>2157 Electric Co.</u> <u>129</u> Business name <u>512 W. 2157</u> License No. Address <u>John R. Davis</u> Signed <u>John R. Davis</u> Date <u>7-5-77</u> Authorized representative		

Forward the white, blue and pink copies to the Department of Health and Environment

Form WWC-5