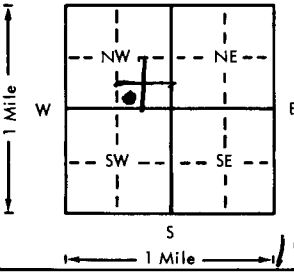
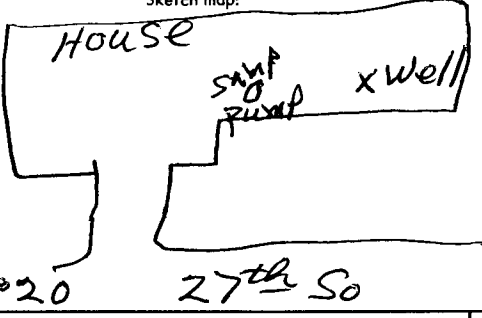


USE TYPEWRITER OR BALL
POINT PEN-PRESS FIRMLY,
PRINT CLEARLY.

WATER WELL RECORD
KSA 82a-1201-1215

Kansas Department of Health and
Environment-Division of Environment
(Water well Contractors)
Topeka, Kansas 66620

1. Location of well:		County <u>Sedgwick</u>	Fraction <u>SE NW</u> <u>SW 1/4</u> SW 1/4 <u>1/4</u>	Section number <u>6</u>	Township number T <u>28</u> S R <u>1 E</u> <u>QW</u>	Range number
2. Distance and direction from nearest town or city: Street address of well location if in city: <u>1820 W 27th So</u>				3. Owner of well: <u>Earl McDaniel</u> R.R. or street: <u>1820 W 27th So.</u> City, state, zip code: <u>Wichita KS 67217</u>		
4. Locate with "X" in section below:		Sketch map:		6. Bore hole dia. <u>9</u> in. Completion date <u>8-16-77</u> Well depth <u>23</u> ft.		
				7. ☐ Cable tool ☐ Rotary ☐ Driven ☐ Dug ☐ Hollow rod ☐ Jetted ☒ Bored ☐ Reverse rotary		
5. Type and color of material				8. Use: ☐ Domestic ☐ Public supply ☐ Industry ☒ Irrigation ☐ Air conditioning ☐ Stock ☒ Lawn ☐ Oil field water ☐ Other		
<u>Gray Clay</u> <u>" Fine Sand</u> <u>" medium gravel</u>				9. Casing: Material <u>RMP</u> Height <u>Above</u> or below Threading <u>Welded</u> Surface <u>12</u> in. RMP ☒ PVC ☐ Weight <u> </u> lbs./ft. Dia. <u>4</u> in. to <u>0</u> ft. depth Wall thickness: inches or Dia. <u>4</u> in. to <u>23</u> ft. depth gage No. <u>20</u>		
				10. Screen: Manufacturer's name <u>Sunflower</u> <u>Inc Co</u> Type <u>RMP</u> Dia. <u>1 1/2</u> " Slot/gauge <u>3/16</u> Length <u>5 FT</u> Set between <u>18</u> ft. and <u>23</u> ft. ft. and <u> </u> ft. Gravel pack? <u>No</u> Size range of material <u> </u>		
				11. Static water level: <u>4</u> ft. below land surface Date <u>8-16-77</u> mo./day/yr.		
				12. Pumping level below land surfaces: <u>4</u> ft. after <u>1</u> hrs. pumping <u>30</u> g.p.m. <u> </u> ft. after <u> </u> hrs. pumping <u> </u> g.p.m. Estimated maximum yield <u>100</u> g.p.m.		
				13. Water sample submitted: <u> </u> mo./day/yr. ☐ Yes ☒ No Date <u> </u>		
				14. Well head completion: ☐ Pitless adapter <u>12</u> inches above grade		
				15. Well grouted? <u>yes</u> With: ☐ Neat cement ☐ Bentonite ☒ Concrete Depth: From <u>0</u> ft. to <u>4</u> ft.		
				16. Nearest source of possible contamination: <u>sump pump</u> ft. <u>10</u> Direction <u>W</u> Type <u> </u> Well disinfected upon completion? ☐ Yes ☒ No		
				17. Pump: ☒ Not installed Manufacturer's name <u>Sears</u> Model number <u> </u> HP <u>1/2</u> Volts <u>115</u> Length of drop pipe <u>20</u> ft. capacity <u>30</u> g.p.m. Type: ☒ Submersible ☐ Turbine ☒ Jet ☐ Reciprocating ☐ Centrifugal ☐ Other		
				20. Water well contractor's certification: This well was drilled under my jurisdiction and this report is true to the best of my knowledge and belief. <u>Protheroe Pump Well 295</u> Business name <u>827 W 27th So</u> License No. <u> </u> Address <u> </u> Signed <u>Protheroe</u> Date <u>8-16-77</u> Authorized representative		
18. Elevation:		19. Remarks:				
Topography: ☐ Hill ☐ Slope ☐ Upland ☒ Valley		<u>Well in Basement</u> <u>Grouted to 4 ft only</u> <u>(Water level)</u>				

Forward the white, blue and pink copies to the Department of Health and Environment

Form WWC-5